


STATE OF KANSAS  
STATE CORPORATION COMMISSION

WELL PLUGGING RECORD

Give All Information Completely  
Make Required Affidavit  
Mail or Deliver Report to:  
Conservation Division  
State Corporation Commission  
800 Bittling Building  
Wichita, Kansas

Stafford County, Sec. 34 Twp. 24 Rge. 12 (E) W (W)

Location as "NE/CNW $\frac{1}{4}$ SW $\frac{1}{4}$ " or footage from lines NE NE NE  
Lease Owner Peel-Hardman Oil Producers  
Lease Name Goldie Dale Well No. 1  
Office Address P. O. Box 359, Hoisington, Kansas  
Character of Well (completed as Oil, Gas or Dry Hole) Dry Hole  
Date well completed April 17 19 53  
Application for plugging filed April 17 19 53  
Application for plugging approved April 17 19 53  
Plugging commenced April 17 19 53  
Plugging completed April 17 19 53  
Reason for abandonment of well or producing formation Dry Hole

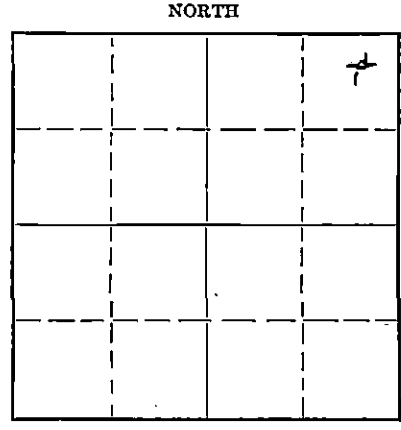

Locate well correctly on above Section Plat

If a producing well is abandoned, date of last production 19  
Was permission obtained from the Conservation Division or its agents before plugging was commenced? Yes

Name of Conservation Agent who supervised plugging of this well Mr. Rives, Pratt, Kansas  
Producing formation Depth to top Bottom Total Depth of Well Feet  
Show depth and thickness of all water, oil and gas formations.

OIL, GAS OR WATER RECORDS

CASING RECORD

Formation	Content	From	To	Size	Put In	Pulled Out
		0	358 $\frac{1}{2}$ '	8 5/8"	358 $\frac{1}{2}$ '	None

Describe in detail the manner in which the well was plugged, indicating where the mud fluid was placed and the method or methods used in introducing it into the hole. If cement or other plugs were used, state the character of same and depth placed, from feet to feet for each plug set.

4150' - 301 $\frac{1}{2}$ ' - Heavy Rotary Mud  
301 $\frac{1}{2}$ ' - 300' - Wooden Plug  
300' - 239' - 20 sacks cement  
239' - 36 $\frac{1}{2}$ ' - Heavy Rotary Mud  
36 $\frac{1}{2}$ ' - 35' - Wooden Plug  
35' - 6' - 10 sacks cement  
6' - Surface - Cellar

(If additional description is necessary, use BACK of this sheet)

Name of Plugging Contractor Peel Brothers, Inc.  
Address P. O. Box 88, Hoisington, Kansas

STATE OF Kansas COUNTY OF Barton, ss.  
Peel Brothers, Inc. (employee of owner) or (owner/operator) of the above-described well,

being first duly sworn on oath, says: That I have knowledge of the facts, statements, and matters herein contained and the log of the above-described well as filed and that the same are true and correct. So help me God. PEEL BROTHERS, INC.

BY: P. D. Sutton  
(Signature) P. O. Box 88, Hoisington, Kansas  
(Address)

SUBSCRIBED AND SWORN TO before me this 20th day of April, 1953

My commission expires January 9, 1957  
Notary Public.

23-8390-s 6-51-20M 4-24-53

PLUGGING  
FILE SEC 34 T 24 R 12 W  
BOOK PAGE 94 LINE 0

DRILLER'S LOG

Company: Peel-Hardman Oil Prod.

NE NE NE  
Sec. 34, Twp. 24S, Rge. 12W

Farm: Goldie Dale Well No. 1

Total Depth: 4150'

County: Stafford,  
Kansas

Comm: 4-1-53 Comp: 4-17-53

Contractor: Peel Brothers, Inc.

Elevation:

Casing:

8 5/8" 358 1/2' cem.

Production: Dry

Figures below indicate bottom of formations

Surface Clay & Sand	0 -	75
Sand		130
Shale		360
Shale, Shells & Red Bed		590
Shale		680
Anhydrite		1150
Shale & Shells		1640
Lime & Shale		3515
Lime		3825
Lime & Shale		3905
Shale		3940
Lime & Shale		3967
Cherty Lime		4065
Cherty Lime & Shale		4120
Lime		4150
Total Depth		4150

This is to certify that the above information is to the best of my knowledge true and correct.

PEEL BROTHERS, INC.

BY: R. E. Sutton

SUBSCRIBED AND SWORN to before me this 20<sup>th</sup> day of April, 1953.

My commission expires January 9, 1957 Maris B. Welch  
Notary Public

RECEIVED  
STATE CORPORATION COMMISSION  
APR 24 1953  
CONSERVATION DIVISION  
Wichita, Kansas

PLUGGING  
FILE SEC 34 T24 R 12W  
BOOK PAGE 94 LINE 30