

STATE OF KANSAS
STATE CORPORATION COMMISSION

WELL PLUGGING RECORD

Give All Information Completely
Make Required Affidavit
Mail or Deliver Report to
Conservation Division
State Corporation Comm.
245 North Water
Wichita, KS 67202

Stafford County. Sec. 4 Twp. 24S Rge. 12W ~~XXX~~
Location as "NE/CNW $\frac{1}{2}$ SW $\frac{1}{2}$ " or footage from lines _____

C-SE SE NE

Lease Owner Hawn Petroleum, Inc.
Lease Name Heyen Well No. 1
Office Address Box 1065, McPherson, Kansas 67460
Character of Well (Completed as Oil, Gas or Dry Hole) _____


Dry Hole

Date Well completed November 23, 1978
Application for plugging filed Verbal Application 19____
Application for plugging approved Verbal Approval 19____
Plugging commenced November 23, 1978
Plugging completed November 23, 1978
Reason for abandonment of well or producing formation _____

If a producing well is abandoned, date of last production _____ 19____

Was permission obtained from the Conservation Division or its agents before plugging was commenced? Yes

Name of Conservation Agent who supervised plugging of this well Wm. T. Owen
Producing formation _____ Depth to top _____ Bottom _____ Total Depth of Well 2,330'
Show depth and thickness of all water, oil and gas formations.

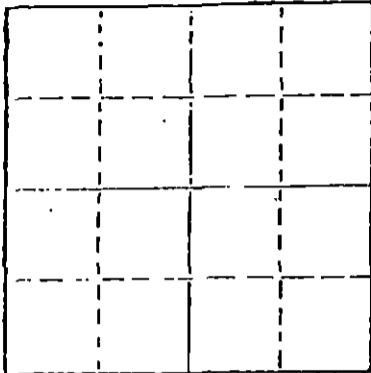

Locate well correctly on above Section Plot

OIL, GAS OR WATER RECORDS

CASING RECORD

FORMATION	CONTENT	FROM	TO	SIZE	PUT IN	PULLED OUT
				8-5/8"	294'	None

Describe in detail the manner in which the well was plugged, indicating where the mud fluid was placed and the method or methods used in introducing it into the hold. If cement or other plugs were used, state the character of same and depth placed, from _____ feet to _____ feet for each plug set.

Filled hole with heavy rotary mud from 2,330 ft. (rotary total depth) to 540 ft. Set plug at 540 ft. and cemented with 50 sacks cement. Filled hole with heavy rotary mud from 540 ft. to 300ft. Set plug at 300 ft. and cemented with 40 sacks cement. Filled hole with heavy rotary mud from 300 ft. to 40 ft. Set solid plug at 40 ft. and cemented to cellar with 12 sacks cement, 3 sacks cement in rathole.

Plugging operations accomplished utilizing Allied Oil Well cementing pump truck through 4 1/2 inch drill pipe.

(If additional description is necessary, use BACK of this sheet)

Name of Plugging Contractor Allied Cementing Co., Inc.
Box 31, Russell, Kansas 67665

STATE OF Kansas COUNTY OF Sedgwick, ss.
Dean Britting, Agent (~~XXXXXX~~ of owner) ~~XXXXXXXXXXXXXXXXXXXX~~

of the above-described well, being first duly sworn on oath, says: That I have knowledge of the facts, statements, and matters herein contained and the log of the above-described well as filed and that the same are true and correct. So help me God.

(Signature) Dean Britting
200 N. Main, Wichita, Kansas 67202
(Address)

SUBSCRIBED AND SWORN TO before me this 29th day of November, 19 78

My commission expires July 25, 1982

Elsie Willison
Elsie Willison - Notary Public.

RECEIVED
STATE CORPORATION COMMISSION
11-30-78
NOV 30 1978

CONSERVATION DIVISION
Wichita, Kansas

KANSAS DRILLERS LOG

COMPANY Hawn Petroleum, Inc.

SEC. 4 T. 24S R. 12W

FARM Heyen

NO. 1

LOC. C-SE SE NE

COUNTY Stafford

ROTARY TOTAL DEPTH 2,330'

COMM. November 17, 1978 COMP. November 23, 1978

CONTRACTOR H-30, Inc. (Rig #7)

ISSUED November 29, 1978

CASING

10 3/4"

8 5/8" Set at 294' cemented w/250 sxs cement

5 1/2"

4 1/2"

ELEVATION 1,875'K.B.

FIGURES INDICATE BOTTOM OF FORMATIONS

Sand and Shale	300'
Shale and Shells	925'
Shale, Shells and Lime	1,639'
Lime and Shale	2,330'
Rotary Total Depth	2,330'

I hereby certify the above and foregoing to be a true and correct log of the above described well as shown by the drilling reports.

H-30, Inc.

Dean Britting
Dean Britting

State of Kansas }
County of Sedgwick } SS:

Subscribed and Sworn to before me a Notary Public in and for said county and state this 29th day of

November, 1978.

Elsie Willison
Elsie Willison - Notary Public

My Commission Expires:

July 25, 1982

RECEIVED
STATE CORPORATION COMMISSION

NOV 30 1978

CONSERVATION DIVISION
Wichita, Kansas