


STATE OF KANSAS
STATE CORPORATION COMMISSION

WELL PLUGGING RECORD

Give All Information Completely
Make Required Affidavit
Mail or Deliver Report to:
Conservation Division
State Corporation Commission
800 Bittling Building
Wichita, Kansas

Stafford County, Sec. 2 Twp. 24 Rge. 12 (W)
Location as "NE/CNW $\frac{1}{4}$ /SW $\frac{1}{4}$ " or footage from lines SE SE SE $\frac{1}{4}$
Lease Owner M. B. Armer
Lease Name Wm. Hildebrand "B" Well No. 3
Office Address 710 Petroleum Bldg., Wichita, Kansas
Character of Well (completed as Oil, Gas or Dry Hole) dry
Date well completed 10/18 19 50
Application for plugging filed 11/27 19 50
Application for plugging approved 11/27 19 50
Plugging commenced 11/27 19 50
Plugging completed 12/2 19 50
Reason for abandonment of well or producing formation dry
If a producing well is abandoned, date of last production 19
Was permission obtained from the Conservation Division or its agents before plugging was commenced? yes

NORTH

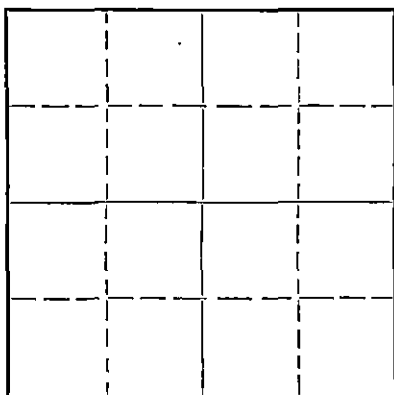

Locate well correctly on above
Section Plat

Name of Conservation Agent who supervised plugging of this well C. D. Stough
Producing formation Viola Depth to top 3805 $\frac{1}{2}$ Bottom 3830 Total Depth of Well 3830 Feet
Show depth and thickness of all water, oil and gas formations.

OIL, GAS OR WATER RECORDS

CASING RECORD

Formation	Content	From	To	Size	Put In	Pulled Out
				8-5/8	195	none
				5 $\frac{1}{2}$	3806	1876

Describe in detail the manner in which the well was plugged, indicating where the mud fluid was placed and the method or methods used in introducing it into the hole. If cement or other plugs were used, state the character of same and depth placed, from _____ feet to _____ feet for each plug set.

Plugged back with crushed rock to 3800 ft., dumped 5 sax cement with dump boiler. Top of cement 3765 ft. Filled with mud to 197 ft., set rock bridge, dumped 15 sax cement. Top of cement at 135 ft., filled with mud to 40 ft., set rock bridge, dumped 10 sax cement for cap.

RECEIVED
STATE CORPORATION COMMISSION
12-14-50
DEC 14 1950

(If additional description is necessary, use BACK of this sheet)

Correspondence regarding this well should be addressed to M. B. Armer
Address 710 Petroleum Bldg., Wichita 2, Kansas

STATE OF Kansas, COUNTY OF Sedgwick, ss.
L. C. Sponenberg (employee of owner) or (owner or operator) of the above-described well,
being first duly sworn on oath, says: That I have knowledge of the facts, statements, and matters herein contained and the log of the above-described well as filed and that the same are true and correct. So help me God.

(Signature) *L. C. Sponenberg*
710 Petroleum Bldg., Wichita 2, Kansas
(Address)

SUBSCRIBED AND SWORN to before me this 12th day of December, 19 50.

Sept. 17, 1951

My commission expires

28-5091-S 8-50-10M

PLUGGING
FILE SEC 2 T 24 R 12 W
BOOK PAGE 46 LINE 41

Hazel Walton
Notary Public.

LOG

Owner: M. B. Armer et al
Contractor: Speer Drilling Company
Drilling commenced: 9/28/50
Drilling completed: 10/11/50
Elevation: 1857 R. B.
1855 D. F.
1852 Gr.

Farm: Wm. Hildebrand - #3B
Location: SE SE SE 1/4 2-24-12,
Stafford County, Kansas
Casing Record: 8-5/8" set @ 195 ft.
with 200 sacks cement
5-9/16" set @ 3805 w/100 sacks
Corrected to 3806

(FIGURES BELOW INDICATE BOTTOMS)

Clay, sand, red bed & shells	195
Red bed	524
Red bed & shale	635
Anhydrite	655
Shale	735
Shale & shells	1055
Shale	1460
Lime	1990
Shale	2080
Lime & shale	2625
Lime	2735
Lime & shale	2940
Lime	3160
Shale & lime	3500
Shale, lime broken	3760
Shale	3804 1/2
Lime, Viola 3806 corr. =	3807
Total Depth - rotary	3807

FORMATION TOPS: (R. B. meas.)

Heebner	3249
Brown Lime	3399
Lans. KC	3430
Viola 3804 1/2 corr. =	3805 1/2

I hereby certify that this is a true and correct log of the above described well as shown by the drilling reports.

SPEER DRILLING COMPANY

RECEIVED
STATE CORPORATION COMMISSION

DEC 14 1950

By [Signature]

STATE OF KANSAS)
) SS
COUNTY OF SEDGWICK)

Subscribed and sworn to before me, a notary public, in and for said County and State this 12th day of October, 1950.

[Signature]
Notary Public

My commission expires Sept. 17, 1951.

PLUGGING
FILE SEC 2 T W R W
BOOK PAGE 46 LINE 4