

Give All Information Completely  
Make Required Affidavit  
Mail or Deliver Report to:  
Conservation Division  
State Corporation Commission  
211 No. Broadway  
Wichita, Kansas

WELL PLUGGING RECORD

Stafford County. Sec. 2 Twp. 24S Rge. 12 (E) W (W)

Location as "NE/CNW/SW" or footage from lines C N/2 SW/4 SE/4

Lease Owner Muir-Thompson, Inc.

Lease Name MW Hildebrand Well No. 1

Office Address 820 Quincy St., Topeka, Kansas

Character of Well (completed as Oil, Gas or Dry Hole) Dry hole

Date well completed 8/27 19 63

Application for plugging filed Verbally, 8/26/63 19

Application for plugging approved Verbally, 8/26/63 19


Plugging commenced Midnite, 8/26/63 19

Plugging completed 4 A.M. 8/27/63 19

Reason for abandonment of well or producing formation \_\_\_\_\_

If a producing well is abandoned, date of last production \_\_\_\_\_ 19 \_\_\_\_\_

Was permission obtained from the Conservation Division or its agents before plugging was commenced? Yes

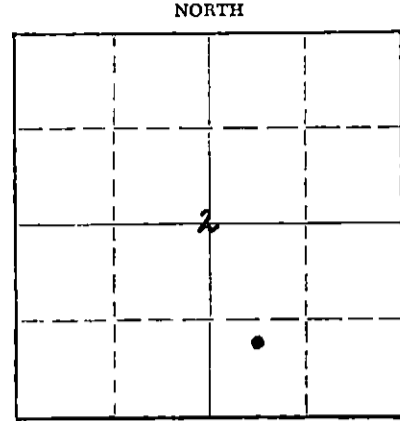

Locate well correctly on above Section Plot

Name of Conservation Agent who supervised plugging of this well Archie V. Elving, Pratt, Ks.

Producing formation \_\_\_\_\_ Depth to top \_\_\_\_\_ Bottom \_\_\_\_\_ Total Depth of Well 3976 Feet

Show depth and thickness of all water, oil and gas formations.

OIL, GAS OR WATER RECORDS

CASING RECORD

FORMATION	CONTENT	FROM	TO	SIZE	PUT IN	PULLED OUT
		0	224	8 5/8"	224	None

Describe in detail the manner in which the well was plugged, indicating where the mud fluid was placed and the method or methods used in introducing it into the hole. If cement or other plugs were used, state the character of same and depth placed, from \_\_\_\_\_ feet to \_\_\_\_\_ feet for each plug set.

Mudded TD to 280 ft.  
Set plug at 280 ft, plus 1/2 sack hulls,  
Run 30 sacks cement,  
mudded to 36 ft.  
Set plug at 35 ft, plus 1/2 sack hulls,  
Run 12 sacks cement.

RECEIVED  
STATE CORPORATION COMMISSION  
9-27-63  
SEP 27 1963

CONSERVATION DIVISION  
Wichita, Kansas

(If additional description is necessary, use BACK of this sheet)

Name of Plugging Contractor Bea Drilling Co., Inc.

Address Box 247, Ellinwood, Kansas

STATE OF Kansas COUNTY OF Barton, ss.

C. F. Krehbiel, Agent (Employee of owner) or (Owner or operator) of the above-described

well, being first duly sworn on oath, says: That I have knowledge of the facts, statements, and matters herein contained and the log of the above-described well as filed and that the same are true and correct. So help me God.

(Signature) C. F. Krehbiel

Box 247, Ellinwood, Kansas

(Address)

SUBSCRIBED AND SWORN TO before me this 4th day of September, 19 63

My commission expires Oct 28 1964

Notary Public.



Muir-Thompson, Inc.  
#1 Hildebrand  
C N/2 SW/4 SE/4  
Sect. 2-24S-12W  
Stafford County, Ks.

Contractor:  
Bea Drilling Co., Inc.  
Box 247, Ellinwood, Ks.

Staked: 8/9/63                      Elevation:  
Started: 8/10/63  
Set Surface: 8/13/63              Formation Tops:  
Completed: 8/27/63

Casing Record: Run 11 jts (224.53 ft) 8 v thd 28# 8 5/8" casing cemented w/150 sacks cement. Circulated. Plug down: 1 A.M. 8/13/63. Job by Halliburton.

Drill Stem Tests: (1) 3429-3519, open 30" good blow. Rec. 330' sogcm, 2130' gas above fl. 30 min ISIP 998 FSIP 998#, IFP 97#, FFP 203#.  
(2) 3519-3552, open 30" good blow throughout test, rec. 375' sogcsw, 1040' gas. 30" ISIP 1196# FSIP 1163#, IFP 65#, FFP 190#.  
(3) 3560-3572, open 1 hr, Weak blow 30", rec. 30' mud. IFP 8#, FFP 8#, FSIP 844#.  
(4) 3579-3617, open 1 hr 30 min. Weak blow, rec. 90' muddy water. IFP 20#, FFP 32#, FSIP 1138#.  
(5) 3791-3840, Open 30 min. Good blow decreasing, 30 min. Rec. 150 watery mud. 30 min ISIP 147#, FSIP 147#, IFP 34#, FFP 147#.  
(6) 3967-3972, open 20 min. Very weak blow for 2 min, no BHP taken, (tool slid & blow was bled off. Rec. 69' mud. IFP 65#, FFP 65#.  
(7) 2656-2736, open 30", good blow decreasing, rec. 120' mud. No shut-in pressures. IFP 40#, FFP 73#.  
(8) 2658-2710 Misrun.

Drillers Log

(All measurements to bottom of formation)  
Sand 110  
Sand & shale 150  
Shale & shells 260  
Red bed & shale 634  
Anhydrite 650  
Shale & shells 1160  
Shale & lime 1810  
Lime & shale 2290  
Shale & lime 2320  
Shale & sdy lime 2715  
Shale w/lime 2830  
Shale & lime 2925  
Lime 3030  
Lime & shale 3105  
Lime w/shale 3132  
Lime & shale 3290  
Shale & lime 3430  
Lime 3465  
Lime w/shale 3506  
Lime 3745  
Lime w/shale & chert 3890  
Shale & lime 3965  
Arbuckle 3976  
Total Depth 3976

RECEIVED  
STATE CORPORATION COMMISSION  
SEP 27 1963  
CONSERVATION DIVISION  
Wichita, Kansas

I hereby certify that the above is a true and correct log of said well as reflected by the daily drilling reports.

C. F. Krehbiel  
C. F. Krehbiel, Vice-Pres.  
Bea Drilling Co., Inc.

STATE OF KANSAS, COUNTY OF BARTON, ss

Subscribed and sworn to before me this 4th day of September, 1963.

Thos. Doherty  
Notary Public

My commission expires Oct 28 - 1964