


STATE OF KANSAS  
STATE CORPORATION COMMISSION  
Give All Information Completely  
Make Required Affidavit  
Mail or Deliver Report to:  
Conservation Division  
State Corporation Commission  
800 Bitting Building  
Wichita, Kansas

### WELL PLUGGING RECORD

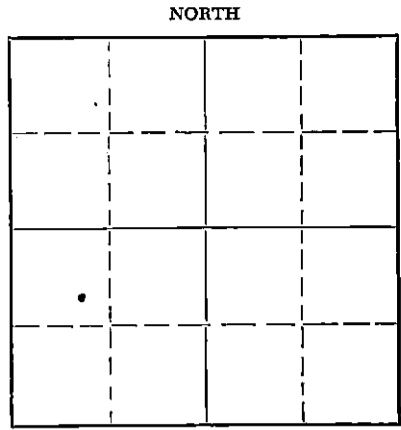

Stafford County, Sec. 4 Twp. 24 Rge. 12 (E) W. (W)  
Location as "NE/CNW/SW" or footage from lines 990' S. & 990' E. of W/4 Cor.  
Lease Owner: Cities Service Oil Company  
Lease Name: Kelly "B" Well No. 1  
Office Address: Great Bend, Kansas  
Character of Well (completed as Oil, Gas or Dry Hole): Gas Well  
Date well completed: March 19, 19 52  
Application for plugging filed: August 8, 19 55  
Application for plugging approved: August 10, 19 55  
Plugging commenced: August 23, 19 55  
Plugging completed: August 29, 19 55  
Reason for abandonment of well or producing formation: Depleted formation.

Locate well correctly on above Section Plat

If a producing well is abandoned, date of last production: December, 19 54  
Was permission obtained from the Conservation Division or its agents before plugging was commenced? Yes  
Name of Conservation Agent who supervised plugging of this well: Warren H. Homer  
Producing formation: Viola Depth to top: 3793 Bottom: 3809 Total Depth of Well: 3941 Feet  
Show depth and thickness of all water, oil and gas formations. P. B. T. D. 3925'

#### OIL, GAS OR WATER RECORDS

#### CASING RECORD

FORMATION	CONTENT	FROM	TO	SIZE	PUT IN	PULLED OUT
				8-5/8"	313'	None
				5-1/2"	3941'	1794'

Describe in detail the manner in which the well was plugged, indicating where the mud fluid was placed and the method or methods used in introducing it into the hole. If cement or other plugs were used, state the character of same and depth placed, from \_\_\_\_\_ feet to \_\_\_\_\_ feet for each plug set.

3925-3780', sand.  
3780-3740', cement.  
3740- 300', mud.  
300- 230', rock bridge and 20 sacks cement.  
230- 35', mud.  
35' to base of cellar, rock bridge and 10 sacks cement.

(If additional description is necessary, use BACK of this sheet)

Name of Plugging Contractor: Walker Drilling Co., Inc. - Chas. D. Wilson, Operator  
Address: 2921 Bonita, Great Bend, Kansas

STATE OF Kansas, COUNTY OF Barton, ss.  
V. M. Conover (employee of owner) or ~~(owner or operator)~~ of the above-described well, being first duly sworn on oath, says: That I have knowledge of the facts, statements, and matters herein contained and the log of the above-described well as filed and that the same are true and correct. So help me God.

(Signature) V. M. Conover  
Box 751, Great Bend, Kansas  
(Address)

SUBSCRIBED AND SWORN TO before me this 12th day of September, 19 55

My commission expires March 12, 1959.

W. G. Smith  
Notary Public.

RECEIVED  
STATE CORPORATION COMMISSION

SEP 15 1955  
9-13-55

PLUGGING  
FILE SEC 4 T 24 R 12W  
BOOK PAGE 141 LINE 19