


STATE OF KANSAS
STATE CORPORATION COMMISSION

WELL PLUGGING RECORD

Give All Information Completely
Make Required Affidavit
Mail or Deliver Report to:
Conservation Division
State Corporation Commission
800 Biting Building
Wichita, Kansas

Pratt County. Sec. 32 Twp. 29S Rge. (E) 14 (W)
Location as "NE/CNW/SW" or footage from lines NW/4 NW/4 SE/4
Lease Owner Skelly Oil Company
Lease Name G. G. Eubank Well No. 1
Office Address Box 1650, Tulsa, Oklahoma
Character of Well (completed as Oil, Gas or Dry Hole) Dry Hole
Date well completed June 27, 19 53
Application for plugging filed June 29, 19 53
Application for plugging approved June 30, 19 53
Plugging commenced June 28, 19 53
Plugging completed June 28, 19 53
Reason for abandonment of well or producing formation Dry Hole

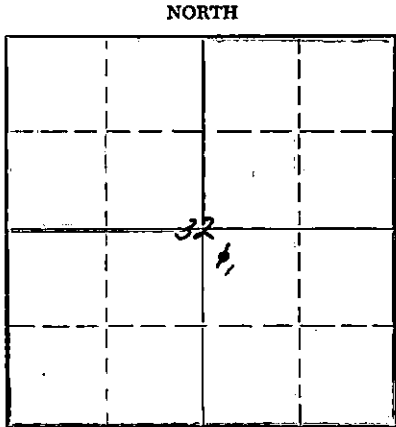

Locate well correctly on above Section Flat

If a producing well is abandoned, date of last production 19
Was permission obtained from the Conservation Division or its agents before plugging was commenced? Yes (Verbally)

Name of Conservation Agent who supervised plugging of this well Mr. M. A. Rives
Producing formation Depth to top Bottom Total Depth of Well 4755 Feet
Show depth and thickness of all water, oil and gas formations.

OIL, GAS OR WATER RECORDS

CASING RECORD

FORMATION	CONTENT	FROM	TO	OD SIZE	PUT IN	PULLED OUT
Arbuckle Lime	Dry	4722'	4755'	8-5/8"	843' 9"	None

Describe in detail the manner in which the well was plugged, indicating where the mud fluid was placed and the method or methods used in introducing it into the hole. If cement or other plugs were used, state the character of same and depth placed, from feet to feet for each plug set.

Mud laden fluid 4755' to 300'
1 sack of hulls and Halliburton plug 300'
20 sacks of cement 300' to 235'
Mud laden fluid 235' to 40'
1 sack of hulls and Halliburton plug 40'
20 sacks of cement 40' to 6'
Surface soil 6' to 0'

Recta
CONCLUDED
Wichita, Kansas
DIVISION

(If additional description is necessary, use BACK of this sheet)
Name of Plugging Contractor Claude Wentworth Drilling Co., Inc.
Address 910 Palace Building, Tulsa, Oklahoma

STATE OF Kansas, COUNTY OF Reno, ss.
H. E. Wamsley (employee of owner) or (owner or operator) of the above-described well, being first duly sworn on oath, says: That I have knowledge of the facts, statements, and matters herein contained and the log of the above-described well as filed and that the same are true and correct. So help me God.

(Signature) [Signature]
Box 391, Hutchinson, Kansas (Address)

SUBSCRIBED AND SWORN TO before me this 10th day of July, 19 53

My commission expires April 7, 1955 [Signature] Notary Public.

PLUGGING
FILE SEC 32 T 29 R 176
BOOK PAGE 111 LINE 8

SKELLY OIL COMPANY



Well Record

Lease Name and No. **G. O. Zubank #49443** Well No. **1** Elev. **2005' RB**
2003' DF
 Lease Description **NE/4 & S/2 Section 32-29E-14N,**
Pratt County, Kansas (480 Acres)
 Location made **May 27, 1953** by **Pratt County Engineer**
330 feet from North line **330** feet from East line **SE/4**
330 feet from South line **330** feet from West line of **Sec. 32**

Work com'd **5/28 1953** Rig com'p'd **5/31 1953** Drlg. com'd **5/31 1953** Drlg. com'p'd **6/27 1953**
 Rig Contractor **Claude Wentworth Drilling Co., Inc.**
 Drilling Contractor **Claude Wentworth Drilling Co., Inc., Tulsa, Oklahoma**
 Rotary Drilling from **0'** to **4755'** Cable Tool Drilling from _____ to _____

Commenced Producing _____ 19 _____
 Initial Prod. before shot or acid _____ Bbls.
 Initial Prod. after shot or acid _____ Bbls.
 Dry Gas Well Press _____ Volume _____ Cu. ft.
 Casing Head Gas Pressure _____ Volume _____ Cu. ft.
 Braden Head (_____ Size) Gas Pressure _____ Volume _____ Cu. ft.
 Braden Head (_____ Size) Gas Pressure _____ Volume _____ Cu. ft.

PRODUCING FORMATION **DRY HOLE** (Name) Top _____ Bottom _____ TOTAL DEPTH **4755'**

CASING RECORD

OD Size	Wt.	Thds.	Where Set	PULLED OUT			LEFT IN			KIND	Cond'n	CEMENTING	
				Jts.	Feet	In.	Jts.	Feet	In.			Sacks Used	Method Employed
8-5/8"	28#	8H	841'				39	843'	9	R1-LW	B	475	Halliburton
(8-5/8" casing set 2' in cellar)													

Liner Set at _____ Length _____ Perforated at _____
 Liner Set at _____ Length _____ Perforated at _____
 Packer Set at _____ Size and Kind _____
 Packer Set at _____ Size and Kind _____

SHOT OR ACID TREATMENT RECORD

Date	FIRST		SECOND		THIRD		FOURTH	
	Ft. and	Ft.	Ft. and	Ft.	Ft. and	Ft.	Ft. and	Ft.
Acid Used								
Size Shot								
Shot Between								
Size of Shell								
Put in by (Co.)								
Length anchor								
Distance below Cas'g								
Damage to Casing or Casing Shoulder								

SIGNIFICANT GEOLOGICAL FORMATIONS

NAME	Top	Bottom	GAS		OIL		REMARKS
			From	To	From	To	
Heebner Shale	3880'						
Tonganoxie Sand	3915'						
Lansing Lime	4072'						
Mississippi Lime	4522'						
Viola Lime	4556'						
Simpson Sand	4647'						
Arbuckle Lime	4722'						

CLEANING OUT RECORDS

	DATE COMMENCED	DATE COMPLETED	PROD. BEFORE	PROD. AFTER	REMARKS
1st					See Reverse for other details.
2nd					" " " " "
3rd					" " " " "
4th					" " " " "

PLUGGING BACK AND DEEPENING RECORDS

	Date Commenced	Date Completed	No. Feet Plugged Back or Deepened	Prod. Before	Prod. After	REMARKS
1st						See Reverse for other details.
2nd						" " " " "
3rd						" " " " "
4th						" " " " "

(See Reverse for Record of Formation)

PLUGGING
 FILE SEC **32-29E-14N**
 BOOK PAGE **111** LINE **8**

RECORD OF FORMATIONS

FORMATION	TOP	BOTTOM	REMARKS
Shale and sand	0	75	
Sand	75	155	
Red shale	155	315	
Shale and shells	315	338	
Anhydrite	338	341	
Drilled 12-1/4" hole	338		TOP ANHYDRITE 338' Set and cemented 8-5/8" OD, 28#, 32 thd., R-1, L.W. steel casing (B cond.) at 341' with 475 sacks of Pozmix cement and 1% calcium chloride. Cement circulated.
Lime	341	350	
Shale	350	1535	
Shale and shells	1535	1750	
Lime and shale	1750	1935	
Shale and shells	1935	2145	
Lime and shale	2145	2375	
Lime	2375	2465	
Lime and shale	2465	2560	
Shale and lime	2560	3230	
Lime	3230	3330	
Lime and shale	3330	3550	
Lime	3550	3907	
Very fine grained gray micaceous sand	3907	3925	TOP BROWN SHALE 3880' TOP TORONTO SAND 3915'

FORMATION	TOP	BOTTOM	REMARKS
Lime and shale	3925	3964	No stain, no odor, some porosity. Ran Halliburton drill stem test, packer set at 3904', used 21' anchor, open 1 hour, very weak blow for 20 minutes, recovered 8' drilling mud, BHP-1257%.
Lime	3964	4013	
Lime and shale	4013	4052	
Lime	4052	4378	TOP BROWN LIME 4053' TOP LANSING LIME 4072'
Broken lime	4378	4405	
Lime and shale	4405	4415	
Lime	4415	4454	
Lime and shale	4454	4494	
Lime	4494	4575	TOP MISSISSIPPI LIME 4522' TOP VIOLA LIME 4556'


FORMATION	TOP	BOTTOM	REMARKS
Lime	4575	4580	Ran Halliburton drill stem test, packer set at 4510', used 65' anchor, open 1 hour, strong blow throughout, recovered 840' muddy water and 180' water with slight show of oil, initial flowing pressure 48#, final flowing pressure 427%.
Cored from 4580' to 4585 1/2' - Recovered 2' All conglomerate, mostly green shale and gray and white chert			
Drilled: Reamed hole from 4580' to 4585 1/2'			
Lime	4585 1/2	4592	

FORMATION	TOP	BOTTOM	REMARKS
Cored from 4592' to 4606' - Recovered 14' All conglomerate chert, lime, and sand with bleeding oil in fractures			
Drilled:			
Lime and chert	4606	4616	
Coarse white crystalline with pink-cast lime	4616	4638	Spotted stain, good saturation in a few fragments.
Lime, chert and shale	4638	4648	TOP SIMPSON SHALE 4632' TOP SIMPSON SAND 4647'
Lime and shale	4648	4662	Ran Johnston drill stem test, packer set at 4572', used 90' anchor, packer failed to hold.

FORMATION	TOP	BOTTOM	REMARKS
Shale	4662	4667	Two down, test drill stem test, used two packers, bottom packer set at 4569' and top packer at 4562 1/2', open 2 hours, recovered 200' mud, BHP-1320%, initial flow 150%, final flow 225%.

FORMATION	TOP	BOTTOM	REMARKS

(See Reverse for Record of Formations)

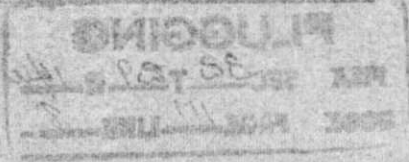

Sand	4667	4668	Ran Johnston drill stem test, bottom packer set at 4645', top packer set at 4630', used 32' anchor, open 2 hours, weak blow throughout, recovered 440' muddy salty water, BHP-1155#, initial flow 0', final flow 0'. <u>TOP ANBUCKLE LINE 4722'</u>
Lime and shale	4668	4730	Wan Schlumberger Survey
Lime	4730	4755	
TOTAL DEPTH		4755'	

As there were no shows of oil or gas in commercial quantities, regular authority was granted to plug and abandon the well.

On June 28, plugged the well as follows:

Mud laden fluid	4755'	to	300'
1 sack of hulls and Halliburton plug			300'
20 sacks of cement	300'	to	235'
Mud laden fluid	235'	to	40'
1 sack of hulls and Halliburton plug			40'
20 sacks of cement	40'	to	6'
Surface soil	6'	to	0'

Plugged and abandoned June 28, 1953.

SLOPE TEST DATA: Tests were taken at 250' intervals from 230' to 4267' inclusive, with no deviation from vertical noted.

MADE IN U.S.A. SKIN

PLUGGING
 FILE SEC 32 T 29 174
 BOOK PAGE 111 LINE 8