


Give Information Completely  
Make Required Affidavit  
Mail or Deliver Report to:  
Conservation Division  
State Corporation Commission  
212 North Market, Insurance Bldg.  
Wichita, Kansas

WELL PLUGGING RECORD

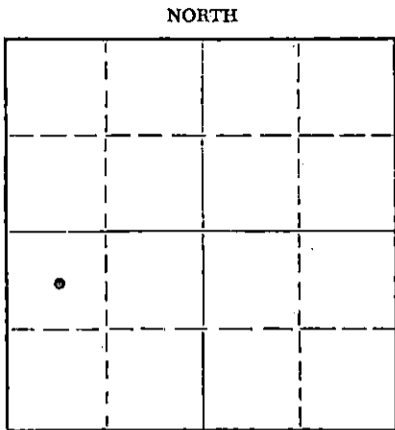

Locate well correctly on above Section Plat

Pratt County, Sec. 32 Twp. 29S Rge. (E) 14 (W)  
Location as "NE/CNW/SW" or footage from lines C-NW/4-SW/4  
Lease Owner Amerada Petroleum Corporation  
Lease Name Georgia Eubank Well No. 1  
Office Address Box 197, Great Bend, Kansas  
Character of Well (completed as Oil, Gas or Dry Hole) Dry Hole  
Date well completed 5-26- 1964  
Application for plugging filed 6-8- 1964  
Application for plugging approved 5-27- 1964  
Plugging commenced 9:30 a.m. 5-26-64 1964  
Plugging completed 11:00 a.m. 5-26 1964  
Reason for abandonment of well or producing formation Dry

If a producing well is abandoned, date of last production - 19 -  
Was permission obtained from the Conservation Division or its agents before plugging was commenced? Yes

Name of Conservation Agent who supervised plugging of this well Archie Elving, Pratt, Kansas  
Producing formation None Depth to top - Bottom - Total Depth of Well 4705 Feet  
Show depth and thickness of all water, oil and gas formations.

OIL, GAS OR WATER RECORDS

CASING RECORD

FORMATION	CONTENT	FROM	TO	SIZE	PUT IN	PULLED OUT
				9-5/8"	306'	None

Describe in detail the manner in which the well was plugged, indicating where the mud fluid was placed and the method or methods used in introducing it into the hole. If cement or other plugs were used, state the character of same and depth placed, from \_\_\_\_\_ feet to \_\_\_\_\_ feet for each plug set.

Filled Hole W/Heavy Mud from 4705' to 275'  
Spotted Cement Plug from 275' to 209' W/30 Sacks Cement and 1-1/2 Sacks Hulls  
Filled Hole with Heavy Mud from 209' to 40'  
Spotted Cement Plug from 40' to Bottom of Celler W/15 Sacks Cement

RECEIVED  
STATE CORPORATION COMMISSION  
6-10-64  
JUN 10 1964

CONSERVATION DIVISION  
Wichita, Kansas

(If additional description is necessary, use BACK of this sheet)  
Name of Plugging Contractor Amerada Petroleum Corporation  
Address Box 197, Great Bend, Kansas

STATE OF Kansas, COUNTY OF Barton, ss.  
Smith Arnold (employee of owner) ~~owner~~ of the above-described well, being first duly sworn on oath, says: That I have knowledge of the facts, statements, and matters herein contained and the log of the above-described well as filed and that the same are true and correct. So help me God.

(Signature) Smith Arnold Foreman  
Box 197, Great Bend, Kansas (Address)

SUBSCRIBED AND SWORN TO before me this 8th day of June, 1964

Charles W. Anderson  
Charles W. Anderson Notary Public.

My commission expires November 21, 1965



DRILLER'S LOG

GEORGIA EUBANK No. 1  
C-NW/4-SW/4  
Section 32:29S-14W  
Pratt County, Kansas

AMERADA PETROLEUM CORPORATION

9-5/8" OD Casing Cemented at 320'  
W/250 Sacks Regular Bulk Cement W/2%  
Calcium Chloride added in last 100 Sacks

Drilling Commenced 5-3-64  
Drilling Completed 5-25-64

FROM	TO	FORMATION	REMARKS
0'	250'	Surface Clay and Sand	Ran Wellex Fracture Finder
250'	600'	Red Bed	Micro-Seisgram and Gamma
600'	835'	Shale	Guard Acoustic Velocity Log.
835'	862'	Anhydrite	
862'	1210'	Red Bed-Shale-Shells	Well Plugged and Abandoned.
1210'	1875'	Shale and Shells	
1875'	2096'	Shale and Lime	
2096'	2410'	Lime	Drilling Contractor:
2410'	2450'	Lime and Shale	Graybol Drilling Company
2450'	2505'	Lime	2200 Nat'l. Bank Building
2505'	3715'	Lime and Shale	Tulsa, Oklahoma
3715'	3825'	Lime	
3825'	4015'	Lime, Shale and Sand	
4015'	4350'	Lime and Shale	
4350'	4450'	Lime	
4450'	4510'	Lime and Shale	
4510'	4550'	Cherty Lime and Shale	
4550'	4553'	Lime	
4553'	4576'	Chert and Shale	
4576'	4612'	Cherty Lime	
4612'	4659'	Lime	
4659'	4695'	Lime and Shale	
4695'	4705'	Sandy Lime	
4705'		Total Depth	

RECEIVED  
STATE CORPORATION COMMISSION

JUN 10 1964

CONSERVATION DIVISION  
Wichita, Kansas