

STATE OF KANSAS
STATE CORPORATION COMMISSION

WELL PLUGGING RECORD

Give All Information Completely
Make Required Affidavit
Mail or Deliver Report to
Conservation Division
State Corporation Comm.
245 North Water
Wichita, KS 67202

Pratt County, Sec. 33 Twp. 29S Rge. 14W E/W
Location as "NE/CNW $\frac{1}{4}$ /SW $\frac{1}{4}$ " or footage from lines
100' N of SE SE SE


Lease Owner Darrel V. Thompson/or Derrick-American Oil
Lease Name Shiver Well No. 1
Office Address 507 Insurance Bldg., Wichita, KS
Character of Well (Completed as Oil, Gas or Dry Hole)
dry hole

Date Well completed November 16 1978
Application for plugging filed November 16 1978
Application for plugging approved November 16 1978
Plugging commenced November 16 1978
Plugging completed November 16 1978
Reason for abandonment of well or producing formation
dry

If a producing well is abandoned, date of last production
19

Was permission obtained from the Conservation Division or
its agents before plugging was commenced? yes

Name of Conservation Agent who supervised plugging of this well Wm. T. Owen
Producing formation Depth to top Bottom Total Depth of well #075
Show depth and thickness of all water, oil and gas formations.

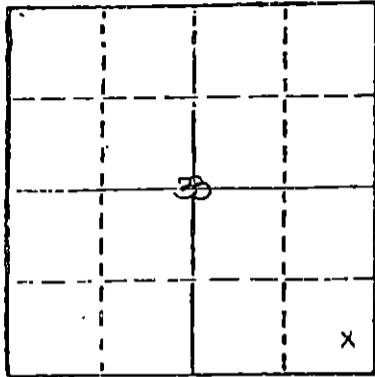

Locate well correctly on above
Section Plat

OIL, GAS OR WATER RECORDS

CASING RECORD

FORMATION	CONTENT	FROM	TO	SIZE	PUT IN	PULLED OUT

Describe in detail the manner in which the well was plugged, indicating where the mud fluid
was placed and the method or methods used in introducing it into the hold. If cement or other
plugs were used, state the character of same and depth placed, from _____ feet to
_____ feet for each plug set.

First plug set at 600' with 50 sacks
Second plug set at 390' ~~sacks~~ with 40 sacks
Third plug set at 40' with 12 sacks
3 sacks in rat hole

RECEIVED
STATE CORPORATION COMMISSION
11-27-78
NOV 27 1978

CONSERVATION DIVISION
Wichita, Kansas

(If additional description is necessary, use BACK of this sheet)
Name of Plugging Contractor Union Drilling Co., Inc.


STATE OF KANSAS COUNTY OF SEDGWICK, ss.
R. D. Messinger (employee of owner) or (owner or operator)
of the above-described well, being first duly sworn on oath, says: That I have knowledge of
the facts, statements, and matters herein contained and the log of the above-described well
as filed and that the same are true and correct. So help me God.

(Signature) R. D. Messinger
505 Union Center, Wichita, Kansas
(Address)

SUBSCRIBED AND SWORN TO before me this 17th day of November, 1978

Cynthia L. Romey
Cynthia L. Romey Notary Public.

My commission expires 6-2-82

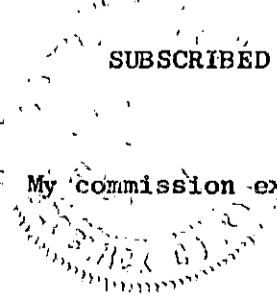

CONTRACTOR'S WELL LOG

OPERATOR: Darrel V. Thompson and/or
 Derrick American Oil, Inc.
 CONTRACTOR: Union Drilling Co., Inc.
 WELL NAME: #1 Shiver
 LOCATION: 100' N of SE SE SE Sec. 33-29S-14W
 Pratt County, Kansas
 COMMENCED: November 5, 1978
 COMPLETED: November 16, 1978

0	1335	Red bed, sand and shale	Set 8, 5/8" @ 391' w/320 sacks
1335	2125	Shale	
2125	2262	Shale and lime	
2262	2670	Shale	
2670	3410	Shale and lime	
3410	3496	Lime	
3496	3800	Lime and shale	
3800	4075	Lime	
	4075	T. D.	

We certify that the above and foregoing is a true and correct copy of the log on the #1 Shiver, 100' N of SE SE SE of Section 33-29S-14W, Pratt County, Kansas.

UNION DRILLING CO., INC.

R. D. Messinger
 R. D. Messinger

STATE OF KANSAS)
) SS
 COUNTY OF SEDGWICK)

Subscribed and sworn to before me, a Notary Public, in and for the aforesaid County and State as of this 17th day of November, 1978.

My appointment expires:
 6-2-82

Cynthia L. Romey
 Cynthia L. Romey - Notary Public

RECEIVED
 STATE CORPORATION COMMISSION
 NOV 27 1978
 CONSERVATION DIVISION
 Wichita, Kansas