


Give All Information Completely
Make Required Affidavit
Mail or Deliver Report to:
Conservation Division
State Corporation Commission
212 North Market, Insurance Bldg.
Wichita, Kansas

WELL PLUGGING RECORD

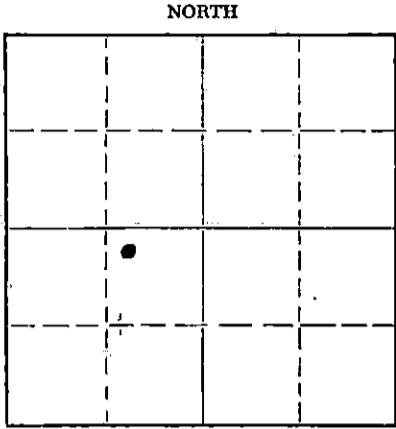

Locate well correctly on above Section Plat

Pratt County, Sec. 29 Twp. 26S Rge. 13(W)
Location as "NE/CNW/SW" or footage from lines 990' WEL and 330' SNL of SW/4
Lease Owner Gulf Oil Corporation
Lease Name Mowbray Well No. 2
Office Address Box 2233, Wichita, Kansas
Character of Well (completed as Oil, Gas or Dry Hole) Oil
Date well completed August 1, 1954
Application for plugging filed October 28, 1958
Application for plugging approved October 30, 1958
Plugging commenced November 20, 1958
Plugging completed November 24, 1958
Reason for abandonment of well or producing formation Well operating below its economic limit.
If a producing well is abandoned, date of last production August 1, 1957
Was permission obtained from the Conservation Division or its agents before plugging was commenced? Yes

Name of Conservation Agent who supervised plugging of this well W. L. Lackamp
Producing formation Simpson Depth to top 4430' Bottom 4437' Total Depth of Well 4470' Feet
Show depth and thickness of all water, oil and gas formations. PBTD 4437'

OIL, GAS OR WATER RECORDS				CASING RECORD		
FORMATION	CONTENT	FROM	TO	SIZE	PUT IN	PULLED OUT
				8-5/8"	500'	-0-
				5-1/2"	4465'	3561'

Describe in detail the manner in which the well was plugged, indicating where the mud fluid was placed and the method or methods used in introducing it into the hole. If cement or other plugs were used, state the character of same and depth placed, from _____ feet to _____ feet for each plug set.
PBTD 4437'. Filled with sand to 4420 1/2 and dumped 5 sacks cement to 4380'. Mudded hole to 400'. Set 10' Rock bridge. Dumped 20 sacks cement to 330'. Filled with mud to 40'. Set Rock bridge from 40' to 30'. Capped to top with 10 sacks cement.

(If additional description is necessary, use BACK of this sheet)
Name of Plugging Contractor Morgan Well Plugging Service
Address 102 W. 18th Street, Hutchinson, Kansas

STATE OF Kansas, COUNTY OF Sedgwick, ss.
Thomas A. Trax (employee of owner) or (owner or operator) of the above-described well, being first duly sworn on oath, says: That I have knowledge of the facts, statements, and matters herein contained and the log of the above-described well as filed and that the same are true and correct. So help me God.

(Signature) [Signature]
Box 2233, Wichita, Kansas
(Address)

SUBSCRIBED AND SWORN TO before me this 1st day of December, 1958

My commission expires 6-3-61 [Signature] C.C. Lewis, Notary Public.

PLUGGING
FILE SEC 29 T. 26 R. 13W
BOOK PAGE 140 LINE 32

RECEIVED
STATE CORPORATION COMMISSION
12-2-58
DEC 2 - 1958
CONSERVATION DIVISION
Wichita, Kansas

E. L. MOORE

MOWBRAY No. 2

NW NE SW 29-26S-13W
Pratt County, Kansas

Conn: 7-12-54
Comp: 7-26-54

Casing: 5-5/8" 422' w/300 sex
5-1/2" 445' w/100 sex

Formation	Depth
Sand and shale	180
Red bed and shells	344
Anhydrite	852
Red bed and shells	1033
Red bed, shale and shells	1485
Shale and shells	1870
Lime and shale	2735
Shale and lime streaks	2970
Shale and lime	3075
Shale	3200
Shale and lime	3415
Lime	3722
Shale	3802
Lime and shale	3914
Lime	3887
Lime and shale	4059
Lime	4137
Chert and lime	4220
Cherty lime and shale	4282
Shale and chert	4333
Chert and lime	4394
Cherty lime and shale	4443
Shale and sand	4470

RECEIVED
STATE CORPORATION COMMISSION

OCT 30 1958

CONSERVATION DIVISION
Topeka, Kansas

STATE OF KANSAS)
) SS:
COUNTY OF SEDGWICK)

L. C. Hay, of lawful age, deposes and states that the above formations and depths are correct as shown by the daily drilling log of the Mowbray No. 2 Well in the NW NE SW 29-26S-13W, Pratt County, Kansas.

L. C. Hay

Subscribed and sworn to before me this 4th day of August, 1954.

Vida Bond

My commission expires Nov. 3, 1958

Notary Public

PLUGGING
FILE SEC 29 T 26 R 13w
BOOK PAGE 140 LINE 38