


WELL PLUGGING RECORD

Give All Information Completely
Make Required Affidavit
Mail or Deliver Report to:
Conservation Division
State Corporation Commission
212 North Market, Insurance Bldg.
Wichita, Kansas

Pratt County. Sec. 29 Twp. 26S Rge. 13 ~~W~~ W (W)
Location as "NE/CNWxSWx" or footage from lines: 990' EWL & 330' SNL of SW/4
Lease Owner Gulf Oil Corporation
Lease Name Mowbray Well No. 1
Office Address Box 2233, Wichita, Kansas
Character of Well (completed as Oil, Gas or Dry Hole) Oil
Date well completed April 2, 19 54
Application for plugging filed October 28, 19 58
Application for plugging approved October 30, 19 58
Plugging commenced November 11, 19 58
Plugging completed November 18, 19 58
Reason for abandonment of well or producing formation Well operating below its economic limit. Evaluation of other formations unsuccessful
If a producing well is abandoned, date of last production 8-23, 19 58
Was permission obtained from the Conservation Division or its agents before plugging was commenced? Yes

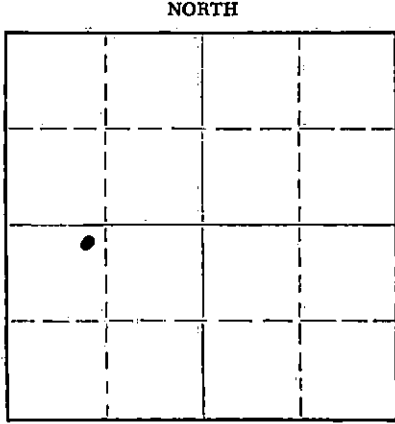

Locate well correctly on above Section Plat

Name of Conservation Agent who supervised plugging of this well W. L. Lackamp
Producing formation Simpson Depth to top 4420' Bottom 4444' Total Depth of Well 4540' Feet
Show depth and thickness of all water, oil and gas formations. PBTD 4330'

OIL, GAS OR WATER RECORDS				CASING RECORD		
FORMATION	CONTENT	FROM	TO	SIZE	PUT IN	PULLED OUT
				8-5/8"	409'	--0--
				5-1/2"	4529'	2214'

Describe in detail the manner in which the well was plugged, indicating where the mud fluid was placed and the method or methods used in introducing it into the hole. If cement or other plugs were used, state the character of same and depth placed, from _____ feet to _____ feet for each plug set.
PBTD 4330'. Filled w/sand to 3904' and dumped 5 sacks cement at 3904'. Filled to 3854'. Mudded hole to 400'. Set 10' Rock bridge. Dumped 8 sacks cement on bridge to 366'. Dumped 12 sacks cement to 330'. Filled w/mud to 40', placed rock bridge to 30' and capped w/10 sacks cement.

(If additional description is necessary, use BACK of this sheet)
Name of Plugging Contractor Morgan Well Plugging Service
Address 102 W. 18th St., Hutchinson, Kansas

STATE OF Kansas, COUNTY OF Sedgwick, ss.
Thomas A. Trax (employee of owner) or (owner or operator) of the above-described well, being first duly sworn on oath, says: That I have knowledge of the facts, statements, and matters herein contained and the log of the above-described well as filed and that the same are true and correct. So Help me God.

(Signature) Thomas A. Trax
Box 2233, Wichita, Kansas (Address)

SUBSCRIBED AND SWORN to before me this 20th day of November 19 58
My commission expires 6-3-61
C. C. Lewis Notary Public.

RECEIVED
STATE CORPORATION COMMISSION
11-22-58
NOV 22 1958

PLUGGING
FILE SEC. 29 T. 26 R. 13
BOOK PAGE 140 LINE 37

RECEIVED
STATE CORPORATION COMMISSION
NOV 22 1958

WELL LOG

H. L. MOORE & CO.

MOBRAY NO. 1

NE NW SW 29-27-13W
Pratt County, Kansas

Comm: 3-15-34
Comp: 4-2-54

Casing: 8-5/8" @ 409' w/350 sax
5" @ 4529' 2/150 sax

<u>Formations</u>	<u>Depth</u>
Sand and gravel	180
Sand and red bed	395
Red bed	410
Red bed, shells and sand	790
Red bed, shale and shells	840
Anhydrite	855
Red bed, shale and shells	1725
Lime, shale and shells	1805
Lime and shells	1980
Lime and shale	3585
Sandy lime and shale	3660
Lime and shale	4025
Lime	4220
Lime and shale	4225
Chert	4285
Cherty Lime	4289
Chert, lime and shale	4320
Shale and chert	4343
Cherty lime and shale	4390
Shale	4425
Shale and sand	4522
Lime	4540 T.D.

STATE OF KANSAS)
(SS:
COUNTY OF SEDGWICK)

L. C. Hay, of lawful age, deposes and states that the above depths and formations are correct as shown by the daily drilling log of the Mobray No. 1 Well in the NE NW SW 29-27-13W, Pratt County, Kansas.

L. C. Hay

Subscribed and sworn to before me this 5th day of April, 1954.

RECEIVED
STATE CORPORATION COMMISSION

L. C. Hay
Notary Public

My commission expires **OCT 30 1953** Nov. 3, 1956

CONSERVATION DIVISION
Wichita, Kansas

PLUGGING
FILE SEC. 29 T. 26 R. 13W
BOOK PAGE 140 LINE 37