


Give All Information Completely
Make Required Affidavit
Mail or Deliver Report to:
Conservation Division
State Corporation Commission
211 No. Broadway
Wichita, Kansas

WELL PLUGGING RECORD

NORTH

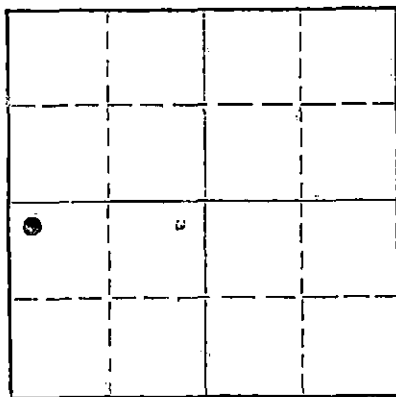

Locate well correctly on above
Section Plat

Butler County, Sec. 25 Twp. 23 Rge. 7 (E) E (W)
Location as "NE/CNW/SW" or footage from lines. NW NW SW $\frac{1}{4}$
Lease Owner L. Fisk Watkins
Lease Name Leonard F. Watkins, Jr. Well No. 1
Office Address 204 S. Atchison, El Dorado, Kansas
Character of Well (completed as Oil, Gas or Dry Hole) Dry Hole
Date well completed 5-5-65 19
Application for plugging filed 5-13-65 19
Application for plugging approved 19
Plugging commenced 5-5-65 19
Plugging completed 5-5-65 19
Reason for abandonment of well or producing formation

If a producing well is abandoned, date of last production 19
Was permission obtained from the Conservation Division or its agents before plugging was commenced? Yes

Name of Conservation Agent who supervised plugging of this well Paul Turpin
Producing formation _____ Depth to top _____ Bottom _____ Total Depth of Well 692' Feet
Show depth and thickness of all water, oil and gas formations.

OIL, GAS OR WATER RECORDS

CASING RECORD

FORMATION	CONTENT	FROM	TO	SIZE	PUT IN	PULLED OUT

Describe in detail the manner in which the well was plugged, indicating where the mud fluid was placed and the method or methods used in introducing it into the hole. If cement or other plugs were used, state the character of same and depth placed, from _____ feet to _____ feet for each plug set.

Mixed and dumped 5 sax cement at 692' TD. Set 15' rock bridge at 173 feet and added 15 sax cement; left hole open from approx 625 feet for a fresh well. All necessary forms have been signed to leave this hole for a stock well.

RECEIVED
STATE CORPORATION COMMISSION

MAY 19 1965
5-19-65

CONSERVATION DIVISION
Wichita, Kansas

(If additional description is necessary, use BACK of this sheet)
Name of Plugging Contractor Thomas Drilling Co., Inc.
Address Box 341, El Dorado, Kansas

STATE OF Kansas COUNTY OF Butler, ss.
Jack O. Thomas (employee of owner) or (owner or operator) of the above-described

well, being first duly sworn on oath, says: That I have knowledge of the facts, statements, and matters herein contained and the log of the above-described well as filed and that the same are true and correct. So help me God.

(Signature) *Jack O. Thomas*
Box 341, El Dorado, Kansas
(Address)

Sworn to before me this 17 day of May, 1965

Nov. 5, 1967
Notary Public

25-23-7E

15-015-30229-0000 62

WELL LOG - Watkins # 1 - NW NW SW 1/4, Section 25, Township 23, Range 7E
Butler County, Kansas

0	-	4	feet	Soil
4	-	50		Lime
50	-	90		Lime, hard
90	-	105		Shale
105	-	125		Lime
125	-	135		Red rock
135	-	143		Lime
143	-	155		Shale
155	-	165		Lime, hard
165	-	185		Shale
185	-	190		Red rock
190	-	205		Lime
205	-	280		Shale
280	-	300		Lime
300	-	315		Shale
315	-	328		Lime
328	-	335		Red rock
335	-	345		Shale
345	-	350		Lime
350	-	400		Shale w/shells
400	-	415		Lime
415	-	440		Shale w/shells
440	-	450		Lime streaks w/shells
450	-	460		Sandy shale
460	-	515		Shale
515	-	525		C Lime
525	-	540		Sandy shale
540	-	560		Shale
560	-	565		Sandy shale
565	-	620		Sandy shale
623	-	646		Sand
646	-	692'		Sandy shale

12 BWPB @ 40-45'
HFW @ 75-80'

HFW @ 540'

RECEIVED
STATE CORPORATION COMMISSION

MAY 19 1965

CONSERVATION DIVISION
Wichita, Kansas

692' TD