

STATE OF KANSAS  
CORPORATION COMMISSIONAll Information Completely  
Made Required Affidavit  
Mail or Deliver Report to:  
Conservation Division  
State Corporation Commission  
800 Bittling Building  
Wichita, Kansas

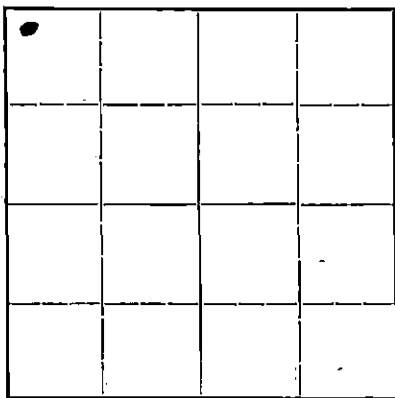
## WELL PLUGGING RECORD

OR

## FORMATION PLUGGING RECORD

Strike out upper line  
when reporting plug-  
ging off formations.

NORTH

Locate well correctly on above  
Section Plat

Stafford County, Sec. 24 Twp. 24 Rge. 11 (E) (West)  
Location as "NE $\frac{1}{4}$ NW $\frac{1}{4}$ SW $\frac{1}{4}$ " or footage from lines NE Cor. NW $\frac{1}{4}$  NW $\frac{1}{4}$   
Lease Owner The Derby Oil Company  
Lease Name Glenn McComb Well No. 3  
Office Address Wichita, Kansas  
Character of Well (completed as Oil, Gas or Dry Hole) Oil Well  
Date well completed October 23 1938  
Application for plugging filed November 4 1941  
Application for plugging approved November 6 1941  
Plugging commenced November 20 1941  
Plugging completed November 25 1941  
Reason for abandonment of well or producing formation Salt water increase, oil  
decreased, not profitable to produce  
If a producing well is abandoned, date of last production August 19 41  
Was permission obtained from the Conservation Division or its agents before plugging was com-  
menced? Yes

Name of Conservation Agent who supervised plugging of this well C. T. Alexander  
Producing formation Misner Depth to top 3803 Bottom 3821 $\frac{1}{2}$ ' Total Depth of Well 3821 $\frac{1}{2}$ ' Feet  
Show depth and thickness of all water, oil and gas formations.

## OIL, GAS OR WATER RECORDS

## CASING RECORD

Formation	Content	From	To	Size	Put In	Pulled Out
				10-3/4"	260	None
				7"	3801	1478'-7"

Describe in detail the manner in which the well was plugged, indicating where the mud fluid was placed and the method or methods used in introducing it into the hole. If cement or other plugs were used, state the character of same and depth placed, from feet to feet for each plug set.

3821 $\frac{1}{2}$  to 3801' Mud and Rock  
3801' to 3781' 5 Sacks Cement  
3781' to 260' Mud  
260' to 240' 22 Sacks Cement  
240' to 30' Mud  
30' to 8' 10 Sacks Cement  
8' to Surface Mud

(If additional description is necessary, use BACK of this sheet)

Correspondence regarding this well should be addressed to The Derby Oil Company  
Address Wichita, Kansas

STATE OF Kansas, COUNTY OF Sedgwick, ss.

S. E. Banks (employee of owner) or (owner or operator) of the above-described well,  
being first duly sworn on oath, says: That I have knowledge of the facts, statements, and matters herein contained and the log of the above-  
described well as filed and that the same are true and correct. So help me God.

(Signature)

The Derby Oil Company, Wichita, Kansas  
(Address)

SUBSCRIBED AND SWORN to before me this 19th day of December, 1941

My commission expires 7-31-43

Notary Public.