

STATE OF KANSAS
STATE CORPORATION COMMISSION

WELL PLUGGING RECORD


Give All Information Completely
Make Required Affidavit
Mail or Deliver Report to:
Conservation Division
State Corporation Commission
300 Bittling Building
Wichita, Kansas

OR

FORMATION PLUGGING RECORD

Strike out upper line
when reporting plug-
ging off formations.

NORTH

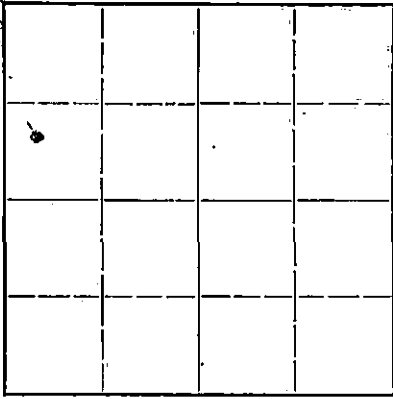

Locate well correctly on above
Section Plot

Stafford County. Sec 24 Twp 24 Rge 11 (E) (W)
Location as "NE 1/4 NW 1/4 SW 1/4" or footage from lines NW SW NW
Lease Owner Sunray Oil Corporation
Lease Name McComb Well No. 2
Office Address
Character of Well (completed as Oil, Gas or Dry Hole) Oil
Date well completed 19 47
Application for plugging filed 3-7 19 47
Application for plugging approved 3-11 19 47
Plugging commenced 3-29 19 47
Plugging completed 4-5 19 47
Reason for abandonment of well or producing formation: Dry

If a producing well is abandoned, date of last production 19
Was permission obtained from the Conservation Division or its agents before plugging was com-
menced? Yes H. W. Kerr

Name of Conservation Agent who supervised plugging of this well
Producing formation Depth to top Bottom Total Depth of Well 3809 Feet
Show depth and thickness of all water, oil and gas formations.

OIL, GAS OR WATER RECORDS

CASING RECORD

Formation	Content	From	To	Size	Put In	Pulled Out
				10"	271'	None
				7"	3795'	2626'

Describe in detail the manner in which the well was plugged, indicating where the mud fluid was placed and the method or methods used in introducing it into the hold. If cement or other plugs were used, state the character of same and depth placed, from feet to feet for each plug set.

Hole was filled from bottom 3809' up into casing, 5 sax cement dumped with bailer. Pipe was pulled from 2626'. The hole was kept full of mud while pipe was being pulled. Rock bridge on mud at 271' cemented with 15 sax. Finished filling with mud and cemented top with 5 sax.

(If additional description is necessary, use BACK of this sheet)

Correspondence regarding this well should be addressed to Toland & Reeves
Address P. O. Box 55, Oklahoma City, Oklahoma

STATE OF Oklahoma COUNTY OF Oklahoma, ss.
Gayle E. Toland (employee of owner) or (owner or operator) of the above-described well,
being first duly sworn on oath, says: That I have knowledge of the facts, statements, and matters herein contained and the log of the above-described well as filed and that the same are true and correct. So help me God.

(Signature) *Gayle E. Toland*
P. O. Box 55, Oklahoma City, Okla.
(Address)

SUBSCRIBED AND SWORN to before me this 5th day of July, 19 47.

Viola Bradley
Notary Public.

My commission expires 6-12-49

PLUGGING
FILE SEC 24 T 24 R 11 W
BOOK PAGE 10 LINE 31