

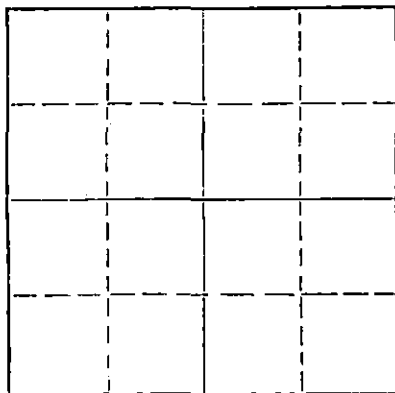
STATE OF KANSAS  
STATE CORPORATION COMMISSION

Form CP-4

Give All Information Completely  
Make Required Affidavit  
Mail or Deliver Report to:  
Conservation Division  
State Corporation Commission  
211 No. Broadway  
Wichita, Kansas

## WELL PLUGGING RECORD

NORTH

Locate well correctly on above  
Section Plat

Stafford County, Sec. 27 Twp. 24 Rge. 11 (E) West (W)  
Location as "NE/CNW/SW" or footage from lines NE NE NE  
Lease Owner Triple D Drilling Company, Inc  
Lease Name McComb Well No. 1  
Office Address 2400 North Main, Hutchinson, Kansas  
Character of Well (completed as Oil, Gas or Dry Hole) D&A  
Date well completed July 10, 1967 19  
Application for plugging filed July 10, 1967 (telephone) 19  
Application for plugging approved July 10, 1967 19  
Plugging commenced July 10, 1967 19  
Plugging completed July 10, 1967 19  
Reason for abandonment of well or producing formation

If a producing well is abandoned, date of last production 19  
Was permission obtained from the Conservation Division or its agents before plugging was commenced? yes

Name of Conservation Agent who supervised plugging of this well Archie Elving, P. O. Box 248, Pratt, Kansas  
Producing formation Depth to top Bottom Total Depth of Well Feet  
Show depth and thickness of all water, oil and gas formations.

## OIL, GAS OR WATER RECORDS

## CASING RECORD

FORMATION	CONTENT	FROM	TO	SIZE	PUT IN	PULLED OUT

Describe in detail the manner in which the well was plugged, indicating where the mud fluid was placed and the method or methods used in introducing it into the hole. If cement or other plugs were used, state the character of same and depth placed, from feet to feet for each plug set.

Filled hole to 250 feet with drilling mud,  
Set plug and put in 25 sacks cement through drill pipe  
Filled hole to 40 feet - set plug - put in 10 sacks of cement  
Dumped 2 sacks cement in rat hole

RECEIVED  
MAY 30 1967  
11-30-67  
CONSERVATION DIVISION  
Wichita, Kansas

(If additional description is necessary, use BACK of this sheet)

Name of Plugging Contractor Triple D Drilling Company, Inc  
Address P. O. Box 831, Hutchinson, Kansas

STATE OF Kansas, COUNTY OF Reno, ss.

R. R. Dutton, President (employee of owner) or (owner or operator) of the above-described well, being first duly sworn on oath, says: That I have knowledge of the facts, statements, and matters herein contained and the log of the above-described well as filed and that the same are true and correct. So help me God.

(Signature)

P. O. Box 831, Hutchinson, Kansas 67501  
(Address)

before me this 17th day of July, 1967

M. L. Bowman

Notary Public.

My co

1969



MC COMB #1

NE NE NE 27-24S-11W

Stafford County, Kansas

Drilling Contractor - Triple D Drilling Co., Inc.,

Drilling Operator - Triple D Drilling & Inc.,

Date Commenced - June 19, 1967

Date Finished - July 8, 1967

-----

0 to	150	Surface soil
150 to	260	Shale
260 to	690	Shell beds
690 to	960	Shale
960 to	1,610	Shale and shells
1,610 to	1,720	Lime and shale
1,720 to	2,180	Lime
2,180 to	2,300	Lime and shale
2,300 to	3,065	Shale and lime
3,065 to	3,748	Lime
3,748 to	3,785	Lime Chert
3,785 to	3,860	Lime - Total depth

CASING RECORD:

Set 260<sup>00</sup>(feet) of 8-7/8 casing  
with 200 sacks of cement