


STATE OF KANSAS
STATE CORPORATION COMMISSION

WELL PLUGGING RECORD

Give All Information Completely
Make Required Affidavit
Mail or Deliver Report to:
Conservation Division
State Corporation Commission
211 No. Broadway
Wichita, Kansas

Reno County, Sec. 24 Twp. 24S Rge. 8W (E) (W)

T 24S NORTH R 8W

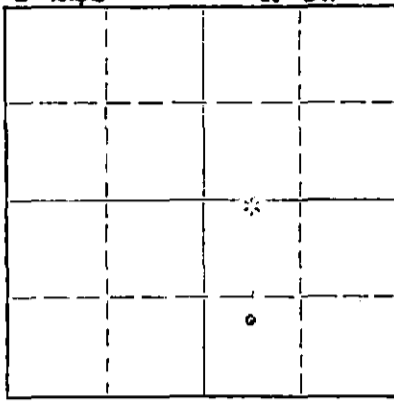

Locate well correctly on above
Section Plat

Location as "NE/CNW/SW" or footage from lines CN/2 SW SE
Lease Owner Stearns Petroleum, Inc.
Lease Name Milburns Well No. 1
Office Address Russell, Kansas
Character of Well (completed as Oil, Gas or Dry Hole) Dry Hole
Date well completed _____ 19____
Application for plugging filed _____ 19____
Application for plugging approved _____ 19____
Plugging commenced May 16 19 56
Plugging completed May 19 19 56
Reason for abandonment of well or producing formation _____

If a producing well is abandoned, date of last production _____ 19____
Was permission obtained from the Conservation Division or its agents before plugging was commenced? Yes

Name of Plugging Agent who supervised plugging of this well Ruel Durkee
Producing formation _____ Depth to top _____ Bottom _____ Total Depth of Well 3530 Feet
Show depth and thickness of all water, oil and gas formations.

OIL, GAS OR WATER RECORDS

CASING RECORD

FORMATION	CONTENT	FROM	TO	SIZE	PUT IN	PULLED OUT
				8-5/8"	210'	None
				5-1/2"	3528'	3178'
				Hole plugged back to 3532 1/2'.		
				Casing perforated at 3526'.		

Describe in detail the manner in which the well was plugged, indicating where the mud fluid was placed and the method or methods used in introducing it into the hole. If cement or other plugs were used, state the character of same and depth placed, from _____ feet to _____ feet for each plug set.

Filled the hole with sand from 3530' to 3515' and ran 16 sacks of cement. Mudded the hole to 200', set a 10' rock bridge and ran 15 sacks of cement. Mudded the hole to 25', set a 10' rock bridge and ran 5 sacks of cement on top. Plugging completed.

RECEIVED
STATE CORPORATION COMMISSION
JUN 18 1956
6-18-56
CONSERVATION DIVISION
Wichita, Kansas

(If additional description is necessary, use BACK of this sheet)
Name of Plugging Contractor West Supply Co., Inc.
Address Chase, Kansas

STATE OF Kansas, COUNTY OF Russell, ss.
R. V. Appleby (employee of owner) or (owner or operator) of the above-described well, being first duly sworn on oath, says: That I have knowledge of the facts, statements, and matters herein contained and the log of the above-described well as filed and that the same are true and correct. So help me God.

(Signature) R. V. Appleby
Box 313, Russell, Kansas
(Address)

SUBSCRIBED AND SWORN TO before me this 28th day of May, 1956

My commission expires April 5, 1958
Betty Law Miller Notary Public.

PLUGGING
FILE SEC 24 T 24 R 8W
BOOK PAGE 62 LINE 39

MILBURN #1

Operator:
 Contractor: Stearns Petroleum, Inc.
 Commencement Date: April 16, 1956
 Completion Date: April 28, 1956
 Elevation: 1634 K. B.
 I. P.: Producer

Location:
 NE SW SE
 Section 24-24S-8W
 Reno County, Kansas

Casing Record:

Ran 10 joints 8-5/8" casing, set at 210 feet. Cemented with 175 sacks Pozmix and 2 sacks Calcium Chloride. Ran 115 joints 5 1/2 inch casing set at 3528 feet and cemented with 50 sacks Pozmix.

WELL LOG

Cellar	0	8
Clay & Sand	8	70
Red Bed	70	210
Shale & Shells	210	835
Shale, Shells, & Salt	835	1300
Shale & Shells	1300	1385
Lime & Shale	1385	3000
Shale	3000	3180
Lime & Shale	3180	3189
Lime	3189	3530
Total Depth	3530	

Tops:

Brown Lime	3166 (-1532)
Lansing	3188 (-1554)
Pay Zone	3528 (-1894)
R. T. D.	3520 (-1896)

RECEIVED
 STATE CORPORATION COMMISSION
 MAY 24 1956
 CONSERVATION DIVISION
 Wichita, Kansas

STATE OF KANSAS)
) SS:
 COUNTY OF RUSSELL)

I hereby certify that the above information is true and correct to the best of my knowledge.

STATE CORPORATION COMMISSION
 MAY 19 1956
 CONSERVATION DIVISION
 Wichita, Kansas

O. G. Stearns
 O. G. Stearns, President

SUBSCRIBED AND SWORN TO BEFORE ME, a Notary Public, this 30th day of April, 1956.

Betty Lou Miller
 Betty Lou Miller, Notary Public

My Commission Expires: April 5, 1958

PLUGGING
 FILE SEC. 24 T. 24 R. 8W
 BOOK PAGE 62 LINE 39