


STATE OF KANSAS
STATE CORPORATION COMMISSION
Give All Information Completely
Make Required Affidavit
Mail or Deliver Report to:
Conservation Division
State Corporation Commission
800 Bittling Building
Wichita, Kansas

WELL PLUGGING RECORD

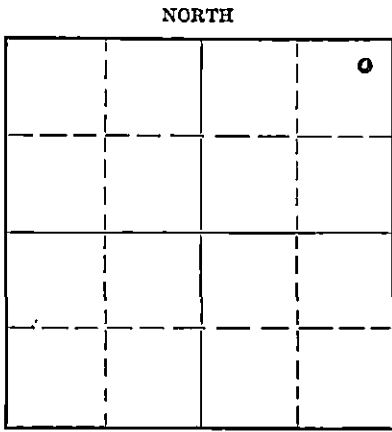

Locate well correctly on above Section Plat

Reno County, Sec. 24 Twp. 24 Rge. 8 (W)
Location as "NE/CNW $\frac{1}{4}$ SW $\frac{1}{4}$ " or footage from lines NE $\frac{1}{4}$ NE $\frac{1}{4}$ NE $\frac{1}{4}$
Lease Owner Ed Wirth & Associates
Lease Name Love 1 A Well No. 1A
Office Address Hutchinson, Kansas
Character of Well (completed as Oil, Gas or Dry Hole) Dry Hole
Date well completed 19...
Application for plugging filed 19...
Application for plugging approved 19...
Plugging commenced 3/8/50 19...
Plugging completed 3/18/50 19...
Reason for abandonment of well or producing formation...
If a producing well is abandoned, date of last production 19...
Was permission obtained from the Conservation Division or its agents before plugging was commenced? Yes

Name of Conservation Agent who supervised plugging of this well...
Producing formation Kansas City Line Depth to top... Bottom... Total Depth of Well 3530' Feet
Show depth and thickness of all water, oil and gas formations.

OIL, GAS OR WATER RECORDS

CASING RECORD

Formation	Content	From	To	Size	Put In	Pulled Out
		0	135'	8 5/8	135'	None
		0	3520'	5 1/2	3520'	3165.98'

Describe in detail the manner in which the well was plugged, indicating where the mud fluid was placed and the method or methods used in introducing it into the hole. If cement or other plugs were used, state the character of same and depth placed, from...feet to...feet for each plug set.

Plugged back with cement to 3524'.
Plugged with 10' of rock
5 sacks of cement.
Mudded back to 200'.
10' of rock, 20 sacks of cement.
Mud to bottom of cellar.
5 sacks of cement.

(If additional description is necessary, use BACK of this sheet)

Correspondence regarding this well should be addressed to...
Address...

STATE OF Kansas, COUNTY OF Reno, ss.

Walker Drilling Co. (employee of owner) or (owner or operator) of the above-described well, being first duly sworn on oath, says: That I have knowledge of the facts, statements, and matters herein contained and the log of the above-described well as filed and that the same are true and correct. So help me God. WALKER DRILLING CO.

(Signature) H. M. Walker


Hutchinson, Kansas (Address)

SUBSCRIBED AND SWORN to before me this 20th day of March, 1950

My commission expires June 23, 1951

My commission expires

[Signature] Notary Public

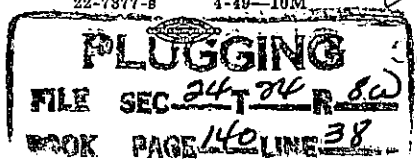

REC'D
MAR 22 1950
3-22-50
KANSAS

WELL LOG W. H. LOVE #1 "A"

Edward L. Wirth et al, Lease Owner

NE-NE-NE Section 24, T. 24 S., R. 8 W.

Donald T. Ingling, Contractor

County: Reno, Kansas

Commenced: September 20, 1949

Location C NE NE NE

Completed: October 7, 1949

Elevation 1630

Total Depth 3524'

Production: 6 barrels

Casing: 135' 8-5/8" Cemented
3520' 5-1/2" OD Cemented 50 Sacks

LOG

55 Surface Shale
72 Sand
135 Red Rock
665 Red Rock and Shale
1000 Salt and Shale
1175 Shale and Shells
1190 Lime and Shale
1380 Lime
1760 Lime and Shale
1855 Shale and Shells
2340 Shale and Lime
2415 Shale and Lime Shells
2510 Shale and Sandy Lime
2712 Shale and Lime
2945 Lime
2975 Shale
3080 Lime
3145 Sand and Shale
3225 Lime
3524 Lime Total Depth

Well Acidized 500 gal
" " 1000 "
" " 3000 "

Shot with 4 qts 3520 to 3524
Acidized 1000 gal

Feb. 1950 Well drilled deeper to 3530'
Cemented with 8 sacks Dumped
Drilled out to 3524'
Shot with 10 qts. from 3518 to 3524'

Bailing test showed well making about 6 barrels per day.

RECEIVED
Conservation Div.
MAR 2 1950
STATE COMMISSION
PLUGGING
COMMISSIONER
KANSAS
BOOK PAGE 140 LINE 38

RECEIVED
Conservation Div.
MAR 21 1950
STATE COMMISSION
CONSERVATION
DIVISION
KANSAS