

WELL PLUGGING RECORD

STATE OF KANSAS
STATE CORPORATION COMMISSION

Give All Information Completely
Make Required Affidavit
Mail or Deliver Report to:
Conservation Division
State Corporation Commission
800 Bittling Building
Wichita, Kansas

FORMATION PLUGGING RECORD

Strike out upper line when reporting plugging of formations.

Reno County, Sec. 24 Twp. 24S Rge. 24S (E) 8 (W)

Location as "NE $\frac{1}{4}$ NW $\frac{1}{4}$ SW $\frac{1}{4}$ " or footage from lines NW/4 NE/4 NE/4

Lease Owner Skelly Oil Company

Lease Name W. A. Love Well No. 2

Office Address Box 1650, Tulsa, Oklahoma

Character of Well (completed as Oil, Gas or Dry Hole) Oil

Date well completed July 11, 19 45

Application for plugging filed Oct. 28, 19 48

Application for plugging approved Oct. 29, 19 48


Plugging commenced Oct. 24, 19 48

Plugging completed Oct. 28, 19 48

Reason for abandonment of well or producing formation Depleted oil well

If a producing well is abandoned, date of last production October 1, 19 48

Was permission obtained from the Conservation Division or its agents before plugging was commenced? Yes (verbally)

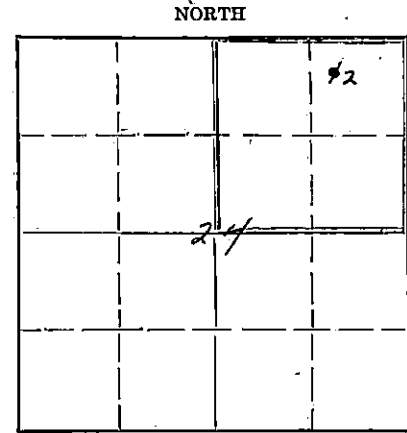

Locate well correctly on above Section Plat

Name of Conservation Agent who supervised plugging of this well Ruel Durkee

Producing formation Lansing Lime Depth to top 3520' Bottom 3522' Total Depth of Well 3546' Feet

Show depth and thickness of all water, oil and gas formations.

OIL, GAS OR WATER RECORDS

CASING RECORD

Formation	Content	From	To	OD Size	Put In	Pulled Out
Lansing Lime	Oil	3520'	3522'	8-5/8"	256'3"	None
				5-1/2"	3549'3"	2853'4"

Describe in detail the manner in which the well was plugged, indicating where the mud fluid was placed and the method or methods used in introducing it into the hole. If cement or other plugs were used, state the character of same and depth placed, from _____ feet to _____ feet for each plug set.

- Crushed rock 3546' to 3520'
- 4 sacks of cement 3520' to 3496'
- Mud laden fluid 3496' to 255'
- 10 sacks of cement 255' to 225'
- Mud laden fluid 225' to 15'
- 3 sacks of cement 15' to 5'
- Surface soil 5' to 0'

RECEIVED
NOV 12 1948
STATE CORPORATION COMMISSION
KANSAS
Rec'd 11-12-48

(If additional description is necessary, use BACK of this sheet)

Correspondence regarding this well should be addressed to Skelly Oil Company

Address Box 391, Hutchinson, Kansas

STATE OF Kansas, COUNTY OF Reno, SS.

H. E. Wamsley (employee of owner) ~~representative~~ of the above-described well, being first duly sworn on oath, says: That I have knowledge of the facts, statements, and matters herein contained and the log of the above-described well as filed and that the same are true and correct. So help me God.


(Signature) _____

Box 391, Hutchinson, Kansas
(Address)


SUBSCRIBED AND SWORN to before me this 11th day of November, 19 48

My commission expires April 7, 1951

Josephine D. Johnson
Notary Public.

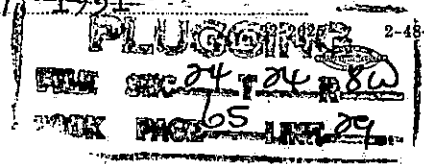

SKELLY OIL COMPANY

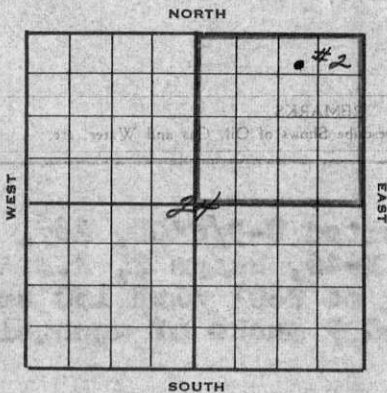

Well Record

Lease Name and No. W. A. Love #10635 Well No. 2 Elev. 1632'DF
 Lease Description NE/4 of Sec. 24-24E-9N,
Reno County, Kansas
 Location made June 1 19 45 by Reno County Engineer
570 feet from North line 990 feet from East line
 feet from South line feet from West line of NE/4 Sec. 24

Work com'd June 3 19 45 Rig comp'd June 4 19 45 Drlg. com'd June 5 19 45 Drlg. comp'd July 7 19 45

Rig Contractor Claude Wentworth Drilling Company

Drilling Contractor Claude Wentworth Drilling Company, Tulsa, Oklahoma

Rotary Drilling from Top to 3522' Cable Tool Drilling from 3522' to 3546'

Commenced Producing July 11 19 45 { Initial Prod. before shot or acid Por. & sat. 3520-22' Bbls.
 Initial Prod. after shot or acid Swabbed 8 hrs., 34 bbls. oil & 20 bbls. water Bbls.

Dry Gas Well Press Volume Cu. ft.

Casing Head Gas Pressure Volume Cu. ft.

Braden Head (8-5/8" x 5 1/2" OD) Gas Pressure Volume Cu. ft.

Braden Head () Gas Pressure Volume Cu. ft.

PRODUCING FORMATION Lansing Line (Name) Top 3521' Bottom 3522' TOTAL DEPTH 3546'

CASING RECORD

Size	Wt.	Thds.	Where Set	PULLED OUT			LEFT IN			KIND	Cond'n	CEMENTING	
				Jts.	Feet	In.	Jts.	Feet	In.			Sacks Used	Method Employed
<u>8-5/8" OD 28#</u>	<u>8r</u>	<u>260</u>					<u>9</u>	<u>256</u>	<u>3</u>	<u>REN H40 R2 A</u>	<u>150</u>	<u>Halliburton</u>	
<u>5-1/2" OD 14#</u>	<u>8r</u>	<u>3521'</u>					<u>113</u>	<u>3549</u>	<u>3</u>	<u>35 H40 R2 A</u>	<u>100</u>	<u>Halliburton</u>	
<u>(8-5/8" casing set 6' in cellar & 5 1/2" cased to derrick floor)</u>													
<u>(Used 1 - 5 1/2" Baker Combination Gulch and Float Shoe)</u>													

Liner Set at Length Perforated at

Liner Set at Length Perforated at

Packer Set at Size and Kind

Packer Set at Size and Kind

SHOT OR ACID TREATMENT RECORD

	FIRST	SECOND	THIRD	FOURTH
Date	<u>July 10, 1945</u>	<u>July 13, 1945</u>		
Acid Used				
Size Shot	<u>2000</u>	<u>2000</u>		
Shot Between	<u>3521 Ft. and 3546 Ft.</u>	<u>3521 Ft. and 3546 Ft.</u>		
Size of Shell	<u>Jetted</u>			
Put in by (Co.)	<u>Halliburton</u>	<u>Halliburton</u>		
Length anchor				
Distance below Cas'g				
Damage to Casing or Casing Shoulder	<u>None</u>	<u>None</u>		

SIGNIFICANT GEOLOGICAL FORMATIONS

NAME	Top	Bottom	GAS		OIL		REMARKS
			From	To	From	To	
<u>Lansing Line</u>	<u>3185'</u>						
<u>Lansing Line rev</u>	<u>3520'</u>				<u>3520'</u>	<u>3522'</u>	<u>Porous & saturated</u>

CLEANING OUT RECORDS

	DATE COMMENCED	DATE COMPLETED	PROD. BEFORE	PROD. AFTER	REMARKS
1st					<u>See Reverse for other details.</u>
2nd					<u>" " " " "</u>
3rd					<u>" " " " "</u>
4th					<u>" " " " "</u>

PLUGGING BACK AND DEEPENING RECORDS

	Date Commenced	Date Completed	No. Feet Plugged Back or Deepened	Prod. Before	Prod. After	REMARKS
1st						<u>See Reverse for other details.</u>
2nd						<u>" " " " "</u>
3rd						<u>" " " " "</u>
4th						<u>" " " " "</u>

(See Reverse for Record of Formation)

RECORD OF FORMATIONS

FORMATIONS TOP BOTTOM REMARKS
Indicate Casing Points, Describe Shows of Oil, Gas and Water, etc.

Surface soil	0	10	
Shale and sand	10	260	Set and cemented 5 1/2" OD, 20' 8rd thd., Grade 2-40, Range 2, A.S.A. steel casing at 260' with 150 sacks of aquagol.
Shale	260	1030	
Shale and shells	1030	1170	
Line and shale	1170	1475	
Shale and shells	1475	1550	
Salt	1550	1565	
Salt, shale & shells	1565	1645	
Shale and shale	1645	1890	
Line	1890	1910	
Shale and shells	1910	2090	
Shale and line	2090	2430	
Chert streaks & lime	2430	2460	
Line and shale	2460	2510	
Line	2510	2600	
Shale and shells	2600	2640	
Line	2640	2660	
Line and shale	2660	2710	
Line	2710	2748	
Line and shale	2748	2787	
Line	2787	2927	
Line and shale	2927	2955	
Line	2955	3030	
Line and shale	3030	3075	
Broken line and shale	3075	3110	
Line and shale	3110	3275	TOP LANSING LINE 3185' SLK
Line	3275	3295	
Line and shale	3295	3317	
Line	3317	3369	
Line and shale	3369	3399	
Broken line	3399	3415	
Line and shale	3415	3478	
Grey lime	3478	3517	
Dark grey shale	3517	3524	TOP LANSING LINE 3520' SLK
Grey and brown oolitic line	3524	3526	

Set and cemented 5 1/2" OD, 14' 8rd thd., Grade 2-40, Range 2, seamless steel casing at 3521' SLK with 100 sacks of cement and 4 sacks of aquagol. Finished cementing at 2:30 PM June 26, 1945. Rigged up logging tools and bailed the hole on July 3, 1945, and 5 1/2" casing tested OK. Drilled cement plug on July 6, 1945, and cement job tested OK. Correction: 3526' SLK rotary table equals 3522' SLK Derrick floor.

ACID TREATMENT RECORD			
FOURTH	THIRD	SECOND	FIRST
Gals. Acid	Gals. Acid	Gals. Acid	Gals. Acid
515	3526	3522	3522
<p>DRILLED:</p> <p>Dense dark grey lime 3522 3527 No porosity or saturation. Tested 12 hours, no show of oil or water.</p> <p>Grey oolitic & cherty lime 3527 3535 No porosity or saturation.</p> <p>Same 3535 3540 No porosity or saturation.</p> <p>Grey and brown crystalline line with trace of chert 3540 3546 No porosity or saturation.</p>			
TOTAL DEPTH		3546'	

Ran 2" tubing and on July 10, 1945, jetted formation from 3521' to 3523' with 2000 gallons of Halliburton acid as follows:

ACID TREATMENT NO. 1 - Between 3521' and 3546'
Treatment put in by Halliburton July 10, 1945, using 2000 gallons acid and 1010 gallons of water to flush:

TIME	GP	TP	REMARKS
9:30 AM		1000'	Started jetting at 1000' pressure
11:30 AM		1000'	1700 gallons acid in tubing
11:40 AM	1000'	800'	1800 gallons of acid in tubing
11:45 AM	600'	1500'	2000 gallons of acid in tubing and started flush
12:05 PM	500'	500'	1010 gallons of water used to flush and treatment complete

After acid treatment, pulled tubing and swabbed through 5 1/2" casing 6 hours, 75 barrels of water (used during acid treatment) and no oil and swabbed to bottom. Then bailed 3 hours, 1/2 barrel acid and 1/2 barrel water per hour.

On July 12th let well stand 12 hours, then bailed 1/2 barrel oil and 3 barrels of water, then tested 9 hours, 5 gallons of oil and 1/2 barrel water per hour.

On July 13th ran 2" tubing and treated with 2000 gallons of Halliburton acid as follows:

(See Reverse for Record of Formation)

ACID TREATMENT NO. 2 - Between 3521' and 3546'

Treatment put in July 13, 1945, by Halliburton, using 2000 gallons acid and 91 barrels of oil to fill hole and to flush:

<u>TIME</u>	<u>CP</u>	<u>TP</u>	<u>REMARKS</u>
4:10 PM			Hole filled with 75 barrels of oil and started acid in
4:30 PM	725'	400'	700 gallons of acid in hole
4:51 PM	825'	500'	1000 gallons of acid in hole
5:09 PM	850'	525'	1300 gallons of acid in hole
5:37 PM	850'	525'	2000 gallons of acid in hole
6:00 PM	800'	800'	Hole flushed with 16 barrels of oil and treatment complete

After acid treatment, swabbed through 2" tubing 10 hours, 60 barrels oil and 5 barrels water. On July 15th swabbed through 2" tubing 10 hours, 22 barrels oil and 16 barrels water. On July 16th swabbed through 2" tubing 8 hours, 34 barrels oil and 20 barrels water and swabbed to bottom. Completed test and shut down to install regular pumping equipment

SLOPE TEST DATA

<u>DEPTH</u>	<u>ANGLE OF DEFLECTION</u>
250'	0 Degrees
500'	0 "
750'	0 "
1000'	0 "
1250'	0 "
1500'	0 "
1750'	0 "
2000'	0 "
2250'	0 "
2500'	0 "
2750'	0 "
3000'	1/2 "
3250'	3/4 "
3500'	3/4 "


 MADE IN U.S.A.

