


WELL PLUGGING RECORD

Give All Information Completely
Make Required Affidavit
Mail or Deliver Report to:
Conservation Division
State Corporation Commission
800 Bittling Building
Wichita, Kansas

NORTH

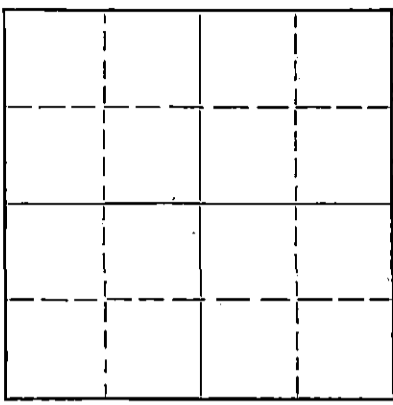

Locate well correctly on above
Section Plat

Reno County. Sec. 6 Twp. 24 Rge. (E) 10 (W)

Location as "NE/CNW $\frac{1}{4}$ SW $\frac{1}{4}$ " or footage from lines 660' N. & 660' E. of S/4 Cor.

Lease Owner Cities Service Oil Company

Lease Name Freeman Well No. 2

Office Address Bartlesville, Oklahoma

Character of Well (completed as Oil, Gas or Dry Hole) Oil Well

Date well completed July 12, 19 52

Application for plugging filed September 9, 19 52

Application for plugging approved September 11, 19 52

Plugging commenced October 19, 19 52

Plugging completed October 25, 19 52

Reason for abandonment of well or producing formation Depleted formation.

If a producing well is abandoned, date of last production September 10, 19 52

Was permission obtained from the Conservation Division or its agents before plugging was commenced? Yes

Name of Conservation Agent who supervised plugging of this well Ruel Durkee

Producing formation Viola Depth to top 3720 Bottom 3738 Total Depth of Well 3738 Feet

Show depth and thickness of all water, oil and gas formations.

OIL, GAS OR WATER RECORDS

CASING RECORD

Formation	Content	From	To	Size	Put In	Pulled Out
				8-5/8"	210'	NONE
				5-1/2"	3725'	1190'

Describe in detail the manner in which the well was plugged, indicating where the mud fluid was placed and the method or methods used in introducing it into the hole. If cement or other plugs were used, state the character of same and depth placed, from _____ feet to _____ feet for each plug set.

3738' - 3710' mud.
3710' - 3662' rock and sand, 6 sacks cement.
3662' - 230' mud.
230' - 180' rock bridge and 15 sacks cement.
180' - 20' mud.
20' - base of cellar, 5 sacks cement.

RECEIVED
CORPORATION COMMISSION
OCT 21 1952

10-31-52
CONSERVATION DIVISION
Wichita, Kansas

(If additional description is necessary, use BACK of this sheet)

Name of Plugging Contractor B. & W. Casing Pulling Co.

Address Great Bend, Kansas

STATE OF Kansas COUNTY OF Barton, ss.
V. M. Conover (employee of owner) or (owner/contractor) of the above-described well,

being first duly sworn on oath, says: That I have knowledge of the facts, statements, and matters herein contained and the log of the above-described well as filed and that the same are true and correct. So help me God.

(Signature) *V. M. Conover*

Box 751, Great Bend, Kansas
(Address)

SUBSCRIBED AND SWORN TO before me this 28th day of October, 19 52

W. G. Smith
Notary Public.

My commission expires March 12, 1955.

PLUGGING
FILE SEC 6-T-24R-024
BOOK PAGE 44 LINE 1

WELL RECORD

Company Cities Service Oil Co. Well No. 2 Farm Freeman
 Location 660' North and 660' East of 3/4 Corner Sec. 6 T. 24 R. 10W
 Elevation 1795 County Reno State Kansas
 Drlg. Comm. June 22, 1943 Contractor Corbett-Parbour Drilling Company
 Drlg. Comp. July 12, 1943 Acid 1000 gals. - July 14, 1943
 T. D. 3738' Initial Prod. B. H. P. Gauge Potential: 3000 oil, no water, 24 hrs.
 (Ind. Cap. 53,441 bbls.)

CASING RECORD:

8-5/8" @ 240' con. 150 sx Monarch
 and 2 sx C. C.
 5-1/2" @ 3725' con. 100 sx Lohigh

Top Viola 3720'
 Penetration 18'
 Total Depth 3738'

FORMATION RECORD:

sand	0-40
sand & gravel	175
shale & shells	245
red bed	478
anhydrite	502
shale	795
shale & shells	1055
salt & shale	1950
shale & shells	1510
lime & shale	1770
sand & shale	1840
shale	1845
shale & lime	2275
shale & shells	2610
shale & lime	2655
lime & shale	2900
lime	3193
shale	3220
lime (lost circ. at 3267)	3305
lime & streaks shale	3414
lime	3461
shale & lime	3580
lime & shale	3660
shale & lime	3720
lime	3731
3731 Rot. TD = 3731 SLM	
lime	3738 T. D.

Good show oil 3732-38.

Byfo:	500'	0°
	1000'	0°
	1500'	0°
	2000'	0°
	3000'	0°
	3600'	1°

RECEIVED
 STATE CORPORATION COMMISSION
 SEP 1 1 1952
 CONSERVATION DIVISION
 Wichita, Kansas

PLUGGING
 FILE SEC. 67-24R
 BOOK PAGE 49 LINE 1