


STATE OF KANSAS
STATE CORPORATION COMMISSION

Give All Information Completely
Make Required Affidavit
Mail or Deliver Report to:
Conservation Division
State Corporation Commission
800 Bittling Building
Wichita, Kansas

WELL PLUGGING RECORD

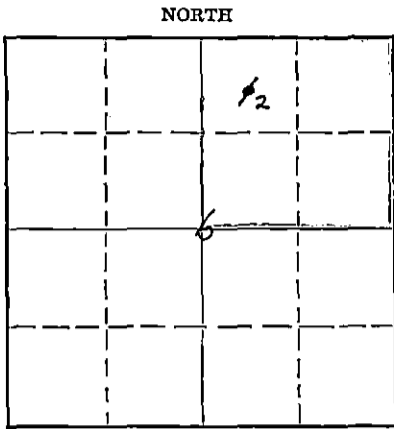

Locate well correctly on above Section Plat

Reno County. Sec. 6 Twp. 24S Rge. (E) 10 (W)
Location as "NE/CNW $\frac{1}{4}$ SW $\frac{1}{4}$ " or footage from lines C. NW $\frac{1}{4}$ NE $\frac{1}{4}$
Lease Owner Skelly Oil Company
Lease Name Cleo Johnson Well No. 2
Office Address Box 1650, Tulsa, Oklahoma
Character of Well (completed as Oil, Gas or Dry Hole) Oil and Gas
Date well completed May 4, 19 43
Application for plugging filed November 14, 19 50
Application for plugging approved November 17, 19 50
Plugging commenced December 3, 19 50
Plugging completed December 8, 19 50
Reason for abandonment of well or producing formation Depleted oil and gas well
If a producing well is abandoned, date of last production August 12, 19 50
Was permission obtained from the Conservation Division or its agents before plugging was commenced? Yes

Name of Conservation Agent who supervised plugging of this well Mr. Ruel Durkee 3726'
Producing formation Viola Lime Depth to top 3690' Bottom 3726' Total Depth of Well PB 3688 Feet
Show depth and thickness of all water, oil and gas formations.

OIL, GAS OR WATER RECORDS

CASING RECORD

Formation	Content	From	To	OD Size	Put In	Pulled Out
Viola Lime	Oil & Gas	3690'	3726'	8-5/8"	351'3"	None
				5-1/2"	3720'3"	2982'0"

Describe in detail the manner in which the well was plugged, indicating where the mud fluid was placed and the method or methods used in introducing it into the hole. If cement or other plugs were used, state the character of same and depth placed, from _____ feet to _____ feet for each plug set.

Mud laden fluid 3688' to 3670'
6 sacks of cement 3670' to 3630'
Mud laden fluid 3630' to 260'
Wood plug 260'
Crushed rock 260' to 250'
15 sacks of cement 250' to 205'
Mud laden fluid 205' to 20'
5 sacks of cement 20' to 5'
Surface soil 5' to 0'

RECEIVED
STATE CORPORATION
DEC 15 1950
CONSERVATION DIVISION
Wichita, Kansas

(If additional description is necessary, use BACK of this sheet)

Correspondence regarding this well should be addressed to Skelly Oil Company
Address Box 391
Hutchinson, Kansas

STATE OF Kansas, COUNTY OF Reno, ss.
H. E. Wamsley (employee of owner/operator) of the above-described well,
being first duly sworn on oath, says: That I have knowledge of the facts, statements, and matters herein contained and the log of the above-described well as filed and that the same are true and correct. So help me God.

(Signature) _____
Box 391, Hutchinson, Kansas (Address)

SUBSCRIBED AND SWORN TO before me this 14th day of December, 19 50

Notary Public.

My commission expires April 7, 1951 23-6001-s 8-50-10M

PLUGGING
FILE SEC 6 T 24 R 10 W
BOOK PAGE 43 LINE 26

SKELLY OIL COMPANY

REPORT OF CHANGE IN WELL RECORD

Give complete description of all cleaning out, deepening, plugging back and fishing jobs, changes in casing, material lost in hole, etc., not recorded in original well record.

LEASE NAME Cleo Johnson WELL NO. 2

CLEANING OUT RECORD				PLUGGING BACK OR DEEPENING RECORD			
Date commenced.....	19.....			Date commenced.....	November 2, 19 50		
Date completed.....	19.....			Date completed.....	November 13, 19 50		
Cleaned out from.....	to.....	T. D.....		Plugged back or deepened from.....	to.....	T. D.....	
Prod. before.....	bbls. oil.....	bbls. water.....	cu. ft. gas.....	Prod. before.....	2 1/2 bbls. oil.....	2 bbls. water.....	14 H cu. ft. gas.....
Prod. after.....	bbls. oil.....	bbls. water.....	cu. ft. gas.....	Prod. after.....	2 gal. oil.....	2 gal. water.....	-- cu. ft. gas.....
Kind of tools used:.....				Kind of tools used:.....	Pulling unit		
Tools owned by:.....				Tools owned by:.....	Skelly Oil Company		

ACID SHOT RECORD

Date	11/10/50					
Size shot	1000 gals. acid			Qts.	Qts.	Qts.
Shot between	3682 Ft. and 3686 Ft.		Ft. and Ft.	Ft. and Ft.	Ft. and Ft.	Ft. and Ft.
Size of shell						
Put in by (Co.)	Dowell Inc.					
Length anchor						
Distance below casing						
Damage to casing or casing shoulder						

CHANGES IN CASING RECORD

SIZE	Wt.	Thds.	Where Set	PULLED OUT		LEFT IN		KIND	Cond'n	CEMENTING	
				Jts.	Feet	In.	Jts.			Feet	In.
5 1/2"			perforated	from	3682'	to	3686'	with 16 holes			

Liner set at..... Length..... Perforated at.....

Packer set at..... Size and kind.....

REMARKS (Give review of work accomplished and any other comment of interest) **On November 2, 1950, pulled tubing and rods. Set bridging plug at 3686' SLM to 3690' SLM. After setting plug, setting tool would not release from plug, and parted line near casing head. Recovered line and setting tool.**

Dumped 30 barrels of water on bridging plug and plug tested OK. Perforated 5 1/2" casing from 3682' to 3686' with 16 holes. Dowell jet shots, no

(Use reverse side for continuation of remarks and for formation record).

DEC 15 1950

Superintendent.

REMARKS (Continued) Show of oil or gas. After setting 15 hours, hole dry, no gas. Treated through 5 1/2" casing with 1000 gallons of Dowell "XRF-27" 7 1/2% acid as follows:

ACID TREATMENT NO. 2 - Between 3682' and 3686'

Treatment put in 11/10/50 by Dowell Inc., using 1000 gallons of oil and 500 gallons of water.

TIME	CP	REMARKS
12:15 pm		1000 gallons of acid in hole
1:40 pm	250'	Hole filled with water
1:51 pm		Start flush
1:57 pm	320'	30 gallons of acid in formation
1:59 pm	0'	65 gallons of acid in formation
2:0 1/2 pm	Vac.	1000 gallons of acid in formation

After setting 60 hours, ran boiler, 6 gallons of oil and no water


RECORD OF FORMATIONS

FORMATION	TOP	BOTTOM	REMARKS Indicate Casing Points, Describe Shows of Oil, Gas and Water, etc.
-----------	-----	--------	---

in hole. On November 13, bailed and tested 3 hours, 2 gallons of oil and 2 gallons of water per hour.

As the Mizener Sand proved to be non-productive in commercial quantities, authority was granted to plug and abandon the well.

SKELLY OIL COMPANY

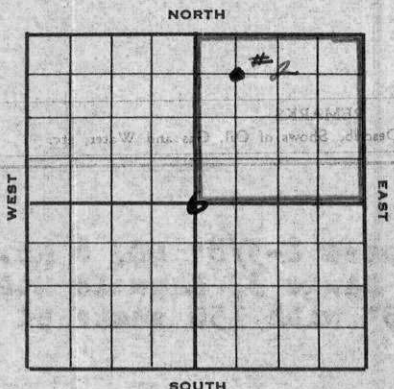

Well Record
 Lease Name and No. Cleo Johnson #10664 Well No. 2 Elev. 1797'
 Lease Description Northeast quarter (NE 1/4) of section 8, Town-
ship 24S, range 10W, Reno County, Kansas
 Location made March 7 1943 by Could Randolph
660 feet from North line 660 feet from East line }
 feet from South line _____ feet from West line } of Sec. 6-24110

Work com'd April 3 1943 Rig com'p'd April 6 1943 Drlg. com'd April 7 1943 Drlg. com'p'd April 27 1943
 Rig Contractor Bodine Drilling Company
 Drilling Contractor Bodine Drilling Company, Great Bend, Kansas
 Rotary Drilling from Top to 3695' Cable Tool Drilling from 3695' to 3726'
 Commenced Producing May 4 1943 Initial Prod. before shot or acid 6,792 bbls. (Indicated) Bbls.
 Initial Prod. after shot or acid _____ Bbls.
 Dry Gas Well Press _____ Volume _____ Cu. ft.
 Casing Head Gas Pressure _____ Volume _____ Cu. ft.
 Braden Head (3-5/8" Size) Gas Pressure _____ Volume _____ Cu. ft.
 Braden Head (_____ Size) Gas Pressure _____ Volume _____ Cu. ft.

PRODUCING FORMATION Viola Lime (Name) Top 3690' Bottom 3726' TOTAL DEPTH 3726'

CASING RECORD

Size	Wt.	Thds.	Where Set	PULLED OUT			LEFT IN			KIND	Cond'n	CEMENTING	
				Jts.	Feet	In.	Jts.	Feet	In.			Sacks Used	Method Employed
8-5/8" OD 28#	8R	355'					9	551	5	Lapweld	"A"	150	Halliburton
8-5/8" casing: Range 3, Grade 7													
5-1/2" OD 14#	8R	3691'					117	3720	3	seamless	"A"	150	Halliburton
5-1/2" casing: Range 2, Grade H-40													
(8-5/8" casing set 6' in collar and 5-1/2" casing cased to derrick floor)													
(Used 1 - 5-1/2" Baker Combination Guide & Float Shoe)													

Liner Set at _____ Length _____ Perforated at _____
 Liner Set at _____ Length _____ Perforated at _____
 Packer Set at _____ Size and Kind _____
 Packer Set at _____ Size and Kind _____

SHOT OR ACID TREATMENT RECORD

	FIRST	SECOND	THIRD	FOURTH
Date	<u>April 26, 1943</u>			
Acid Used	<u>2000</u>			
Size Shot	<u>3691</u>	<u>3726</u>		
Shot Between	Ft. and _____ Ft.	Ft. and _____ Ft.	Ft. and _____ Ft.	Ft. and _____ Ft.
Size of Shell				
Put in by (Co.)	<u>Chemical Process</u>			
Length anchor				
Distance below Cas'g				
Damage to Casing or Casing Shoulder	<u>None</u>			

SIGNIFICANT GEOLOGICAL FORMATIONS

NAME	Top	Bottom	GAS		OIL		REMARKS
			From	To	From	To	
<u>Lansing Lime</u>	<u>3294</u>						
<u>Misener Sand</u>	<u>3682</u>						
<u>Viola Line</u>	<u>3690</u>						<u>PAY FORMATION</u>

CLEANING OUT RECORDS

	DATE COMMENCED	DATE COMPLETED	PROD. BEFORE	PROD. AFTER	REMARKS
1st					See Reverse for other details.
2nd					" " " " "
3rd					" " " " "
4th					" " " " "

PLUGGING BACK AND DEEPENING RECORDS

	Date Commenced	Date Completed	No. Feet Plugged Back or Deepened	Prod. Before	Prod. After	REMARKS
1st						See Reverse for other details.
2nd						" " " " "
3rd						" " " " "
4th						" " " " "

(See Reverse for Record of Formation)

RECORD OF FORMATIONS

FORMATION	TOP	BOTTOM	REMARKS
Surface soil, clay, sand and red bed	0	180	
Red bed	180	355	Set and cemented 5-5/8" OD, 8 Rd. Thread, 28', Range 3, lapweld steel casing at 355' with 150 sacks of cement.
Red bed	355	600	
Shale	600	1025	
Soft and shells	1025	1100	
Shale and shells	1100	1345	
Shale and lime	1345	1460	
Sandy lime	1460	1630	
Lime	1630	1705	
Sandy lime	1705	1825	
Lime	1825	1910	
Shale and lime	1910	1950	
Lime	1950	2150	
Shale and lime	2150	2250	
Shale	2250	2370	
Shale and lime shells	2370	2545	
Lime	2545	2620	
Lime and shale	2620	2750	
Shale and shells	2750	2785	
Lime	2785	2865	
Broken lime	2865	2985	
Lime	2985	3055	
Shale and lime	3055	3200	
Lime	3200	3210	
Shale and lime	3210	3350	TOP LANSING LINE 3294'
Lime	3350	3395	
Shale	3395	3405	
Lime	3405	3415	
Shale and lime	3415	3490	
Lime	3490	3570	
Lime and shale	3570	3615	
Shale	3615	3640	
Shale	3640	3682	TOP BISHOP BAND 3682'
Grey sand with little shale	3682	3686	
Grey sand and green shale	3686	3690	TOP VIOLA LINE 3690'
Grey and brown dolomite	3690	3692	
Grey and brown dolomite	3692	3695	

PLUGGING
 FILE SEC-6-T-R-10-2
 BOOK PAGE 43 LINE 26

Porous, light saturation
 Porous and stained
 Set and cemented 5-1/2" OD, 14 8 Rd. Thread, Range 2, Grade H-40, Seamless steel casing at 3691' with 150 sacks of cement. Finished cementing at 1:30 PM April 21, 1943, and while shut down waiting on cement to set, moved out rotary tools and moved in and rigged up cable tools. Finished rigging up and bailed the hole down on April 25, 1943, and 5-1/2" casing tested OK. Drilled cement plug and cleared out to bottom and cement job tested OK.

FORMATION	TOP	BOTTOM	REMARKS
DRILLED			
Hard grey cherty dolomite	3695	3697	
Sand	3697	3702	
Brown and grey dolomite	3702	3713	Little gas and some oil
Brown and grey dolomite with little chert	3713	3717	Let stand 15 minutes and had good oil to work
Brown and grey cherty dolomite	3717	3723	Fair porosity and saturation, 1200' OIH while drilling and while preparing to drill deeper well started flowing; loaded hole with 60 barrels of water and drilled ahead as follows:
Dense grey dolomite	3723	3726	Porous and saturated
			No saturation
TOTAL DEPTH		3726'	

On April 27, 1943, ran 2" tubing, then swabbed through tubing 6 hours, swabbing water used to load hole. Well then started to flow, flowed into pits 2 hours to clean up hole, 15 barrels of oil and no water, then turned into tank battery to test.

On April 28, 1943, swabbed and flowed through 2" tubing 4 hours, 20 barrels of oil and no water, then treated with 2000 gallons of acid by Chemical Process as follows:

FORMATION	TOP	BOTTOM	REMARKS
ACID TREATMENT NO. 1 - ON THE PLUG			
			Treatment put in by Chemical Process Company, April 28, 1943, using 2000 gallons acid and 16 barrels flushing oil.

TIME	CP	TP	REMARKS:
5:00 PM			Start acid in hole through 2" tubing
5:05 PM	700	400	603 gallons acid in hole (on bottom) Shut down 5 minutes to let acid soak on formation
5:10 PM	500	200	Start pump
5:13 PM	800	500	850 gallons acid in hole (2 pumps)
5:14 PM	725	425	1000 gallons acid in hole (2 pumps)
5:19 PM	700	400	1500 gallons acid in hole (2 pumps)
5:23 PM	525	225	2000 gallons acid in hole (1 pump)
5:26 PM	300	0	Start oil in hole
5:33 PM	250	0	8 barrels oil in hole
5:37 PM	250	50	16 barrels oil in hole (tubing clear)

After acid treatment, swabbed well in through 2" tubing, then allowed well to flow through tubing 9-1/2 hours, 496 barrels of oil and no water, CP 250 TP 125, Choke 1" and gas gauged 1,000 M cu. ft., gas oil ratio 679 cubic feet per barrel.

On May 4, 1943, started potential test, flowed through 2" tubing 16 hours, 486 barrels of oil and no water, static bottom hole pressure 1082 on high rate, bottom hole pressure 960 producing at rate of 1004 barrels per day, gas gauged 702 M cu. ft. gas oil ratio 699 cu. ft. per barrel. Low rate bottom hole pressure 1062, produced at rate of 389 barrels per day, gas gauged 248 M cu. ft., 638 cu. ft. per barrel for indicated productivity of 6792 barrels to establish 24 hour Maximum State Corporation Commission potential of 3000 barrels. This potential allows 75 barrels per day for the remainder of May, 1943.

Depth	SLOPE TEST DATA		Horiz.	Vert.
	Angle of Deflection			
250'	0 Degrees			
500'	1/2	"	2.2	.0
750'	1/2	"	2.2	.0
1000'	1/2	"	2.2	.0
1250'	1/2	"	2.2	.0
1500'	1/2	"	2.2	.0
1750'	0	"		
2000'	0	"		
2250'	0	"		
2500'	0	"		
2750'	0	"		
3000'	1/2	"	2.2	.0
3250'	0	"		
3500'	0	"		
			13.2	.0



Fidelity Oronum SKIN

MADE IN USA

RECEIVED
STATE CORPORATION
DEC 15 1950
CONSERVATION DIVISION
Wichita, Kansas




Fidelity Oronum SKIN