


STATE OF KANSAS
STATE CORPORATION COMMISSION

Give All Information Completely
Make Required Affidavit
Mail or Deliver Report to:
Conservation Division
State Corporation Commission
211 No. Broadway
Wichita, Kansas

WELL PLUGGING RECORD

Pratt County, Sec. 7 Twp. 26 Rge. 13 (E) W (W)

Location as "NE/CNW/SW" or footage from lines NE NE SW
Lease Owner Twin Drilling Co.
Lease Name ~~XXXXXXXXXXXX~~ Toland Well No. 1
Office Address Wichita, Kansas
Character of Well (completed as Oil, Gas or Dry Hole) Dry Hole
Date well completed 8-13-58 19
Application for plugging filed 8-13-58 19
Application for plugging approved 8-22-58 19
Plugging commenced 8-19-58 19
Plugging completed 8-22-58 19
Reason for abandonment of well or producing formation Dry Hole

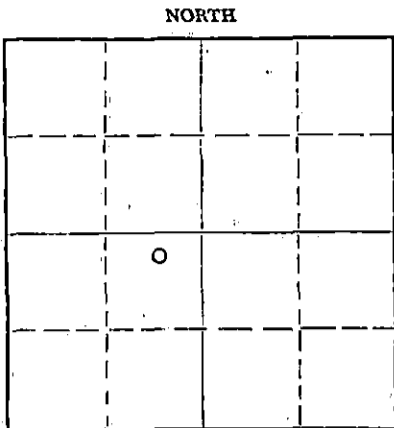

Locate well correctly on above Section Plat

If a producing well is abandoned, date of last production 19
Was permission obtained from the Conservation Division or its agents before plugging was commenced? yes

Name of Conservation Agent who supervised plugging of this well Bill Lackamp
Producing formation _____ Depth to top _____ Bottom _____ Total Depth of Well 4910 Feet
Show depth and thickness of all water, oil and gas formations.

OIL, GAS OR WATER RECORDS

CASING RECORD

FORMATION	CONTENT	FROM	TO	SIZE	PUT IN	PULLED OUT
				13-3/8"	220'	none
				5-1/2"	4120'	2013'

Describe in detail the manner in which the well was plugged, indicating where the mud fluid was placed and the method or methods used in introducing it into the hole. If cement or other plugs were used, state the character of same and depth placed, from _____ feet to _____ feet for each plug set.

Checked the hole to 3946' and found it open. Filled w/sand to 3920' and dumped 5 sacks of cement. Pulled 40 jts 5 1/2" casing. Criculated water out of hole with mud from pit. Pulled ~~more~~ of casing (18 jts) to 220' and pumped in 35 sacks of cement thru casing. Pulled rest of casing (6 jts), cleared hole and mudded to 25', set rock bridge and ran 15 sacks of cement to base of cellar.

RECEIVED
STATE CORPORATION COMMISSION
9-3-58
SEP 7 1958

(If additional description is necessary, use BACK of this sheet)

Name of Plugging Contractor West Supply Co., Inc.
Address Chase, Kansas

STATE OF KANSAS COUNTY OF RICE, ss.
I, Noel J. Knight (employee of owner) or (owner or operator) of the above-described well, being first duly sworn on oath, says: That I have knowledge of the facts, statements, and matters herein contained and the log of the above-described well as filed and that the same are true and correct. So help me God.

(Signature) Noel J. Knight
Chase, Kansas
(Address)

SUBSCRIBED AND SWORN to before me this 27th day of August, 19 58

My commission expires 9-27-58 Thomas V. Hayes Notary Public.

PLUGGING
FILE SEC. 1 T. 26 R. 13W
BOOK 127 LINE 8

WELL LOG BUREAU — KANSAS GEOLOGICAL SOCIETY
412 Union National Bldg., Wichita, Kansas

Company - TEXAS CO.
Fam. - H. Toland

No. 1

SEC. 7
NE o SW

T. 26

R. 13 W

Total Depth. 4496'

Comm. 6-24-44

Comp. 8-13-44


Shot or Treated.

Contractor. Hissom Drlg. Co.

Rotary O-4496

Issued. 11-18-44

County. Pratt
KANSAS

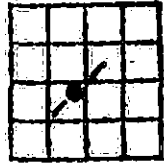

CASING:

13 3/8"

194' Cem

Elevation. _____

Production.

Dry

Figures indicate Bottom of Formations.

surface	204
red bed & shells	400
red bed, shale & sand	835
anhydrite	860
shale & shells	1250
lime & shale	1825
lime sdy	1955
lime brkn	3176
lime & shale	3244
lime brkn	3422
lime & shale	3528
lime & brkn	3550
lime	3702
lime & shale	3844
lime	3938
lime & shale	3972
lime	4152
lime cherty	4316
chert-lime-sand	4332
lime & chert	4374
lime	4392
sand-shale-lime	4408
shale & lime	4438
sand & shale	4448
Arbuckle lime	4460
shale green & lime	4478
lime	4496
Total Depth	

Wash down on Toland #1:

Contractor-Twin Drilling, Inc.
Operator -D. E. Dunne, Jr.

Set 5 1/2" casing at 4120'
Cemented w/80 sax.
Top of cement 3780'

Perforations:

4047-4050 18 shots L-W plug at 4038'
4011-4018 24 shots L-W plug at 3994'
3982-3984 8 shots
3962-3966 17 shots L-W plug at 3946'
3929-3934 20 shots

D & A August 13, 1958

Topo:

Anhydrite	832
Lansing	3791
Congl	4212
Kinderhook	4270
Viola	4308
Simpson	4373
Arbuckle	4444

PLUGGING
FILE SEC. 7 T. 26 R. 13 W
BOOK PAGE 127 LINE 8