

STATE OF KANSAS
STATE CORPORATION COMMISSION

WELL PLUGGING RECORD

Give All Information Completely
Make Required Affidavit
Mail or Deliver Report to:
Conservation Division
State Corporation Commission
212 North Market, Insurance Bldg.
Wichita, Kansas

Pratt

County. Sec. 6 Twp. 26S Rge. (X) 13 (W)

Location as "NE/CNW%SW%" or footage from lines C NE SE SW

Lease Owner Gulf Oil Corporation

Lease Name Henderson

Well No. 1

Office Address P. O. Box 2233, Wichita, Kansas

Character of Well (completed as Oil, Gas or Dry Hole) Oil

Date well completed 7-10 19 55

Application for plugging filed 1-16 19 59

Application for plugging approved 1-19 19 59


Plugging commenced 2-7 19 59

Plugging completed 2-14 19 59

Reason for abandonment of well or producing formation Well operating below its economic limit.

If a producing well is abandoned, date of last production 12-18 19 58

Was permission obtained from the Conservation Division or its agents before plugging was commenced? Yes

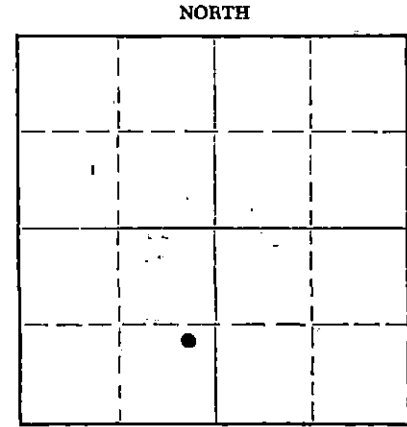

Locate well correctly on above Section Plat

Name of Conservation Agent who supervised plugging of this well W. L. LaKamp

Producing formation Kansas City Lime Depth to top 3917' Bottom 3923' Total Depth of Well 4480' Feet

Show depth and thickness of all water, oil and gas formations. PBTD 4000'

OIL, GAS OR WATER RECORDS

CASING RECORD

FORMATION	CONTENT	FROM	TO	SIZE	PUT IN	PULLED OUT
				8-5/8"	799'	-0-
				5-1/2"	4025'	2213'

Describe in detail the manner in which the well was plugged, indicating where the mud fluid was placed and the method or methods used in introducing it into the hole. If cement or other plugs were used, state the character of same and depth placed, from _____ feet to _____ feet for each plug set.

PBTD 4000'. Filled with sand to 3910' and dumped 5 sacks to 3870'. Mudded hole to 350'. Set rock bridge from 350' to 340'. Dumped 20 sacks cement from 340' to 290'. Mudded hole to 40'. Set rock bridge from 40' to 30'. Cemented to top with 10 sacks cement.

RECEIVED
STATE CORPORATION COMMISSION
2-18-59
FEB 18 1959
CONSERVATION DIVISION
Wichita, Kansas

(If additional description is necessary, use BACK of this sheet)
Name of Plugging Contractor Morgan Well Plugging Service
Address Hutchinson, Kansas

STATE OF Kansas, COUNTY OF Sedgwick, ss.
Thomas A. Trax (employee of owner) or (owner or operator) of the above-described well, being first duly sworn on oath, says: That I have knowledge of the facts, statements, and matters herein contained and the log of the above-described well as filed and that the same are true and correct. So help me God.

(Signature) [Signature]
P. O. Box 2233, Wichita, Kansas
(Address)

SUBSCRIBED AND SWORN TO before me this 17th day of February, 19 59
My commission expires 6-3-61
C. C. LEWIS, NOTARY PUBLIC Notary Public.

JCH:LS

PLUGGING
FILE SEC. 6 T. 26 R. 13W
BOOK PAGE 11 LINE 1

DRILLER'S LOG

Company: W. H. Anoa, Jr.

NE-SE-SW

Sec: 6, Twp: 26S, Rge: 13W

Farm: Henderson Well No: 1

Total Depth: 4480'

County: Pratt, Kansas

Comm: 6/23/55 Comp: 7/10/55

Contractor: Peel Brothers, Inc.

Elevation:

Casing:

8 5/8"

@

799'

Cem.

Production:

5 1/2"

@

4025'

Cem.

Figures below indicate bottom of formation

Sand	220'
Red bed and shale	435'
Sandy shale and shells	1196'
Shale and shells	1380'
Sandy shale and shells	1850'
Shale and lime streaks	2025'
Shale, salt and lime streaks	2185'
Lime	2295'
Lime and shale	2430'
Lime	2560'
Lime and shale	2695'
Shale and lime streaks	3015'
Lime	3120'
Lime and shale	3210'
Lime	3315'
Shale and lime	3365'
Lime	4226'
Lime and shale	4255'
Lime	4300'
Lime and chert	4345'
Lime and shale	4450'
Dolomite	4480'
Total Depth	4480'

This is to certify that the above information is to the best of my knowledge true and correct.

PEEL BROTHERS, INC.

BY [Signature]

SUBSCRIBED AND SWORN TO before me this 12 day of July 1955

My commission expires September 28, 1957

[Signature]
Notary Public

RECEIVED
STATE CORPORATION COMMISSION

JAN 17 1959

CONSERVATION DIVISION
Wichita, Kansas

PLUGGING	
FILE . SEC	<u>6 T. 26 R. 13W</u>
BOOK PAGE	<u>11 LINE 1</u>