


STATE OF KANSAS
STATE CORPORATION COMMISSION
Give All Information Completely
Make Required Affidavit
Mail or Deliver Report to:
Conservation Division
State Corporation Commission
211 No. Broadway
Wichita, Kansas

WELL PLUGGING RECORD

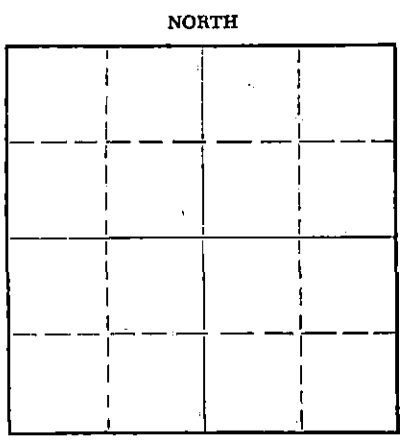

Pratt County, Sec. 32 Twp. 29S Rge. 15W (E) (W)
Location as "NE/CNWxSWx" or footage from lines 150' so. C SW SW
Lease Owner Ferguson Oil Co. & Walters Drilling Co.
Lease Name Wiltshire Well No. 1
Office Address 1505 Wichita Plaza Building
Character of Well (completed as Oil, Gas or Dry Hole) Dry Hole
Date well completed 11-13-65 19
Application for plugging filed 11-13-65 19
Application for plugging approved 11-13-65 19
Plugging commenced 11-13-65 19
Plugging completed 11-13-65 19
Reason for abandonment of well or producing formation commercial quantities of oil not found
If a producing well is abandoned, date of last production 19
Was permission obtained from the Conservation Division or its agents before plugging was commenced? yes

Name of Conservation Agent who supervised plugging of this well Archie Elving
Producing formation _____ Depth to top _____ Bottom _____ Total Depth of Well 4937 Feet
Show depth and thickness of all water, oil and gas formations.

OIL, GAS OR WATER RECORDS				CASING RECORD		
FORMATION	CONTENT	FROM	TO	SIZE	PUT IN	PULLED OUT
				8 5/8"	248'	

Describe in detail the manner in which the well was plugged, indicating where the mud fluid was placed and the method or methods used in introducing it into the hole. If cement or other plugs were used, state the character of same and depth placed, from _____ feet to _____ feet for each plug set.
Bottom plug @ 240' w/ 25 sx.
Top plug @ 40' w/ 10 sx. cement
Rathole - 2 sx cement

RECEIVED
STATE CORPORATION COMMISSION
11-30-65
NOV 30 1965
CONSERVATION DIVISION
Wichita, Kansas

(If additional description is necessary, use BACK of this sheet)
Name of Plugging Contractor Walters Drilling Co.
Address 510 Orpheum Building, Wichita, Kansas

STATE OF KANSAS, COUNTY OF SEDGWICK, ss.
Robert F. Walters of Walters Drilling Co. (employee of owner) or (owner or operator) of the above-described well, being first duly sworn on oath, says: That I have knowledge of the facts, statements, and matters herein contained and the log of the above-described well as filed and that the same are true and correct. So help me God.

(Signature) Robert F. Walters
510 Orpheum Building
(Address)

SUBSCRIBED AND SWORN TO before me this 22nd day of November, 19 65
Juanita M. Green
Juanita M. Green Notary Public.
My commission expires October 4, 1967



DRILLER'S LOG

COMPANY: FERGUSON OIL COMPANY & WALTERS DRILLING CO.
1505 WICHITA PLAZA BUILDING
WICHITA, KANSAS

WELL NAME: WILTSHIRE #1
150' so. of C SW SW SEC. 32-29S-15W
PRATT COUNTY, KANSAS

CONTRACTOR: WALTERS DRILLING CO.
510 ORPHEUM BUILDING
WICHITA, KANSAS

ROTARY DRILLING COMMENCED: OCTOBER 30, 1965
ROTARY DRILLING COMPLETED: NOVEMBER 13, 1965

ELEVATION: 2017 KB

CASING RECORD: 8 5/8" set @ 248' w/ 200 sacks

LOG

0 - 250	Sand and Shale
250 - 1610	Shale
1610 - 2210	Shale and Lime
2210 - 2365	Shale and Lime
2365 - 2641	Lime
2641 - 3045	Lime and Shale
3045 - 3225	Shale and Lime Streaks
3225 - 3660	Shale and Lime
3660 - 3970	Lime and Shale
3970 - 4145	Sand and Shale and Lime
4145 - 4200	Lime and Shale
4200 - 4710	Lime
4710 - 4725	Lime and Chert
4725 - 4750	Lime
4750 - 4797	Lime and Chert
4797 - 4820	Lime
4820 - 4880	Lime
4880 - 4924	Lime and Shale
4924 - 4937	Lime
<u>4937</u>	<u>Rotary Total Depth</u>

RECEIVED
STATE CORPORATION COMMISSION


NOV 30 1965

The undersigned, Robert F. Walters, hereby certifies, in behalf of said company that the above log is a true and correct log of the formations encountered in drilling the above well as reflected by the Daily Drilling Reports.

WALTERS DRILLING CO.

BY 
ROBERT F. WALTERS, Partner

Subscribed and sworn to before me
this 19th day of November, 1965


Juanita M. Green, Notary Public

My Commission Expires:
October 4, 1967