


STATE OF KANSAS  
STATE CORPORATION COMMISSION  
Give All Information Completely  
Make Required Affidavit  
Mail or Deliver Report to:  
Conservation Division  
State Corporation Commission  
211 No. Broadway  
Wichita, Kansas

WELL PLUGGING RECORD

Pratt County, Sec. 4 Twp. 26S Rge. (E) 13(W)  
Location as "NE/CNW&SW" or footage from lines. NW/4 SW/4 SE/4  
Lease Owner Skelly Oil Company  
Lease Name S. F. Chance Well No. 1  
Office Address 1860 Lincoln St., Denver, Colorado  
Character of Well (completed as Oil, Gas or Dry Hole) Oil  
Date well completed June 15, 19 53  
Application for plugging filed July 18, 19 67  
Application for plugging approved July 20, 19 67  
Plugging commenced August 19, 19 67  
Plugging completed August 23, 19 67  
Reason for abandonment of well or producing formation Uneconomical to operate  
If a producing well is abandoned, date of last production July 31, 19 67  
Was permission obtained from the Conservation Division or its agents before plugging was commenced? Yes

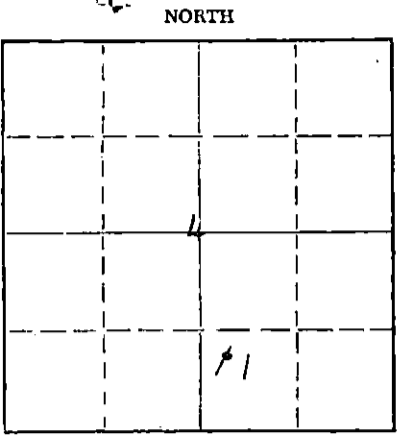

Locate well correctly on above Section Plat

Name of Conservation Agent who supervised plugging of this well Mr. A. Elving  
Producing formation Lansing-K.C. Depth to top 3850' Bottom 3998 1/2' Total Depth of Well 4353 Feet  
Show depth and thickness of all water, oil and gas formations. PB 4001'

OIL, GAS OR WATER RECORDS

CASING RECORD

FORMATION	CONTENT	FROM	TO	SIZE	PUT IN	PULLED OUT
Simpson Sand	Oil	4278'	4289 1/2'	8-5/8"	433'3"	None
Lansing-K.C.	Oil	3850'	3998 1/2'	5-1/2"	4383'6"	2642.15'

Describe in detail the manner in which the well was plugged, indicating where the mud fluid was placed and the method or methods used in introducing it into the hole. If cement or other plugs were used, state the character of same and depth placed, from \_\_\_\_\_ feet to \_\_\_\_\_ feet for each plug set.

Sand	4001' to 3800'
20 sacks of cement	3800' to 3660'
Mud	3660' to 300'
Rock bridge	300' to 290'
24 sacks of cement	290' to 218'
Mud	218' to 40'
Rock bridge	40' to 30'
10 sacks of cement	30' to Base of cellar
Surface soil	Cellar to Surface

RECEIVED  
STATE CORPORATION COMMISSION  
OCT 17 1967  
10-17-67  
CONSERVATION DIVISION  
Wichita, Kansas

(If additional description is necessary, use BACK of this sheet)  
Name of Plugging Contractor Ralph Comstock Pipe Pulling, Inc.  
Address 320 No. Park, Stafford, Kansas 67578

STATE OF Colorado, COUNTY OF Denver, ss.  
Leland Franz (employee of owner) or (owner) of the above-described well, being first duly sworn on oath, says: That I have knowledge of the facts, statements, and matters herein contained and the log of the above-described well as filed, and that the same are true and correct. So help me God.


(Signature) *Leland Franz*  
1860 Lincoln St., Denver, Colo, 80203  
(Address)

SUBSCRIBED AND SWORN TO before me this 16th day of October, 19 67

My commission expires June 17, 1970

*Mary E. ...*  
Notary Public.

# SKELLY OIL COMPANY

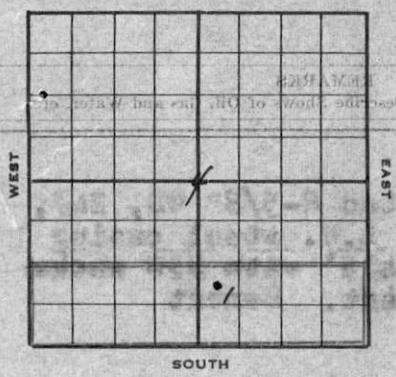

## Well Record

1942<sup>RB</sup>  
1939<sup>DF</sup>  
1935<sup>BH</sup>

Lease Name and No. **S. F. Chance** Well No. **1** Elev. **990**  
 Lease Description **3/2 S/2 Section 4-268-13W,**  
**Pratt County, Kansas (160 Acres)**  
 Location made **April 11,** 19 **53** by **Pratt County Engineer**

Work com'd **4/11** 19 **53** Rig comp'd **4/12** 19 **53** Drlg. com'd **4/12** 19 **53** Drlg. comp'd **5/8** 19 **53**

Rig Contractor **Claude Wentworth Drlg. Co., Inc.**  
 Drilling Contractor **Claude Wentworth Drlg. Co., Inc.**

Rotary Drilling from **0'** to **4337'** Cable Tool Drilling from **4337'** to **4353'**

Commenced Producing **June 15,** 19 **53** Initial Prod. before shot or acid **2 gals. oil, 2 gals. wtr/hr** Bbls.  
 Initial Prod. after shot or acid **no wtr. to estab. 24 hr. 100 potential of** Bbls.

Dry Gas Well Press Volume **178 barrels** Cu. ft.

Casing Head Gas Pressure Volume Cu. ft.

Braden Head (**8-5/8** Size **5 1/2** OD) Gas Pressure Volume Cu. ft.

Braden Head ( ) Gas Pressure Volume Cu. ft.

PRODUCING FORMATION **Simpson Sand** (Name) Top **4278'** Bottom **4289 1/2'** TOTAL DEPTH **4300'**

### CASING RECORD

OD Size	Wt.	Thds.	Where Set	PULLED OUT			LEFT IN			KIND	Cond'n	CEMENTING	
				Jts.	Feet	In.	Jts.	Feet	In.			Sacks Used	Method Employed
8-5/8" 24#	8V		435'				21	433	3	R1 LW	C	350	Halliburton
5-1/2" 17#	8R		4337'				186	4383	6	R1 LW	A	200	Halliburton
(8-5/8" casing set 1' in collar and 5 1/2" cased to derrick floor)													
(5-1/2" casing perforated from 4278' to 4289 1/2' with 71 holes)													
Used 1 - 5 1/2" OD Larkin Combination Guide & Float Shoe													

Liner Set at \_\_\_\_\_ Length \_\_\_\_\_ Perforated at \_\_\_\_\_

Liner Set at \_\_\_\_\_ Length \_\_\_\_\_ Perforated at \_\_\_\_\_

Packer Set at \_\_\_\_\_ Size and Kind \_\_\_\_\_

Packer Set at \_\_\_\_\_ Size and Kind \_\_\_\_\_

### SHOT OR ACID TREATMENT RECORD

	FIRST	SECOND	THIRD	FOURTH
Date	5/11/53			
Acid Used				
Size Shot				
Shot Between	4278 Ft. and 4289 1/2 Ft.	Ft. and Ft.	Ft. and Ft.	Ft. and Ft.
Size of Shell				
Put in by (Co.)	Halliburton			
Length anchor	(Hydrafrac)			
Distance below Cas'g				
Damage to Casing or Casing Shoulder				

### SIGNIFICANT GEOLOGICAL FORMATIONS

NAME	Top	Bottom	GAS		OIL		REMARKS
			From	To	From	To	
Heebner Shale	3531'						
Lansing Lime	3725'						See remarks
Harmaton Lime	4046'						
Conglomerate	4103'						
Mississippi Lime	4141'						
Viola Lime	4213'						
Simpson Sand	4272'				4278'	4289 1/2'	
Arbuckle Lime	4330'						

### CLEANING OUT RECORDS

	DATE COMMENCED	DATE COMPLETED	PROD. BEFORE	PROD. AFTER	REMARKS
1st					See Reverse for other details.
2nd					" " " " "
3rd					" " " " "
4th					" " " " "

### PLUGGING BACK AND DEEPENING RECORDS

	Date Commenced	Date Completed	No. Feet Plugged Back or Deepened	Prod. Before	Prod. After	REMARKS
1st						See Reverse for other details.
2nd						" " " " "
3rd						" " " " "
4th						" " " " "

(See Reverse for Record of Formation)

# RECORD OF FORMATIONS

FORMATION	TOP	BOTTOM	REMARKS
			Indicate Casing Points, Describe Shows of Oil, Gas and Water, etc.
Surface clay and sand	0	180	
Red bed and shells	180	850	Set and cemented 8-5/8" OD, 24#, 8V thd., R-1, L.W. steel casing (C cond.) at 435' with 350 sacks of Pozmix cement. Cement circulated.
Anhydrite	850	870	
Shale and shells	870	1270	
Shale, shells, and salt	1270	1720	
Shale and shells	1720	1885	
Lime and shale	1885	3050	
Lime	3050	3125	
Lime and shale	3125	3230	
Lime	3230	3330	
Lime and shale	3330	3415	
Lime	3415	3635	
Shale and lime	3635	3750	
Buff, fine crystalline partly oolitic lime	3750	3755	Fair porosity, very slight stain, rainbow of oil in wet samples.
Shale and lime	3755	3772	
Buff to brown fine crystalline partly oolitic lime	3772	3777	Floor to fair porosity, very slight stain, rainbow of oil in wet sample
Lime	3777	3778	Ran Halliburton drill stem test, packer set at 3738', open 2 hours, gas to surface in 7 minutes, recovered 245' gas cut mud, 60' salt water, gas estimated 250 M.C.F. BHP-1415#.
Lime	3778	3809	
Buff, fine crystalline lime	3809	3821	Slightly porous and slightly cherty, spotted oil stain, very good odor in samples.
Lime	3821	3868	
Buff, finely crystalline oolitic lime	3868	3872	Very good porosity and stain
Lime	3872	3881	
Buff, finely crystalline lime	3881	3905	Very good oolitic to vuggy porosity, good stain and odor.
Lime	3905	3913	
Light gray to buff finely crystalline lime	3913	3956	Slight to good pin point to vuggy porosity, spotted oil stain
Lime	3956	4076	<u>BASE KANSAS CITY 4026'</u> <u>TOP HARKNER LIME 4046'</u>
Gray tripolitic opaque chert	4076	4087	Fair porosity, dead spotted stain to dead oil saturation
Lime	4087	4145	<u>TOP CONGLOMERATE 4103'</u> <u>TOP MISSISSIPPI LIME 4141'</u>
Shale, lime and chert	4145	4195	<u>TOP KINDERHOOK SHALE 4145'</u> <u>TOP MISSOURI SAND 4198'</u>
Gray to brown fine grained angular quartzitic sand	4195	4202	Poor to fair porosity and good stain to saturated rainbow of oil in wet samples
Lime and chert	4202	4205	Ran Halliburton drill stem test, packer set at 4160', open 2 hours, no blow, recovered 10' drilling mud, BHP-20#.
Shale and chert	4205	4225	<u>TOP VIOLA LIME 4213'</u>
Lime and chert	4225	4255	
Shale	4255	4268	<u>TOP SIMPSON SHALE 4265'</u>
<b>Cored from 4268' to 4293' - Recovered 25'</b>			
Top 2' - Red and green sandy shale			
Next 2' - Red and green laminated shale			
Next 5' - Greenish-gray fine grained hard, very shaley sand, bled oil slightly			
Next 4' - Gray fine grained sand with thin green shale bands, no shows			
Next 9' - Gray fine grained hard, slightly shaley sand, bled fair amount of oil			
Last 3' - Dark greenish-gray shale			
<u>TOP SIMPSON SAND 4272'</u>			
Ran Halliburton drill stem test, packer set at 4255', used 38' anchor, open 2 hours, recovered 55' drilling mud, BHP-48#.			

On May 28, loaded hole with 50 barrels of oil. Drilled and drove Lane-wells bridging plug from 3885' to 3998'. Swabbed out oil used to load hole, set Lane-wells bridging plug at 3835', then plugged back from 3835' to 3831' with 1/2 sack of Cal-Seal. Perforated 5 1/2" casing from 3820' to 3825' with 30 holes by Lane-wells; tested 1 hour, no recovery. Perforated 5 1/2" casing from 3813' to 3816' with 18 holes by Lane-wells; tested 1 hour, no recovery. Perforated 5 1/2" casing from 3805' to 3809' with 24 holes by Lane-wells; bailed and tested 3 hours, 1/2 barrel of oil with trace of water per hour. Treated through 5 1/2" casing with 250 gallons of Halliburton 15% acid and 500 gallons of HV acid as follows:

ACID TREATMENT NO. 7 - Between 3805'-09', 3813'-16', and 3820'-25'  
Treatment put in 5/29/57 by Halliburton, using 750 gallons of acid and 90 barrels of oil.

TIME	CP	TP	REMARKS
10:36 am	Vac.		Start acid
11:00 am	1200		Acid on bottom
11:03 am	1350		
11:04 am	850		
11:06 am	800		
11:09 am	700		Flush in, treatment completed

Swabbed through 5 1/2" casing 4 hours, 90 barrels of oil used in treating and 18 barrels of acid water; then swabbed 10 hours, 91 barrels of oil and 25 barrels of water. On May 30, swabbed through 5 1/2" casing 24 hours, 24 barrels of oil and 76 barrels of water. Ran 2" tubing and set Halliburton DM retainer at 3792'.

Cemented off perforations from 3805' to 3809', 3813' to 3816', and from 3820' to 3825' with 75 sacks of common cement, maximum TP-500'. Pulled 2" tubing and shut down for cement to set.

On June 3, swabbed hole dry and 5 1/2" casing tested dry. Drilled retainer at 3792' and cement plug to 3828'. Loaded hole with 50 barrels of oil and drove Lane-wells bridging plugs from 3998' and 3835' to 4001' SLM.

PLUGGED BACK TOTAL DEPTH 4001'

Bailed hole clean and swabbed through 5 1/2" casing 1 hour, 50 barrels of oil used to load hole; then swabbed 18 hours, 392 barrels of oil and 69 barrels of water.

Ran 2" tubing and rods and moved out cable tools on June 5. POB 13 hours, 165 barrels of oil and 16 barrels of water. On June 6, POB 24 hours, 238 barrels of oil and 68 barrels of water.

**RECEIVED**  
STATE CORPORATION COMMISSION

JUL 20 1967

CONSERVATION DIVISION  
Wichita, Kansas

9

DRILLED:

Shale, chert and shells Cream to gray finely crystalline dolomitic lime	4293	4328	<u>TOP ARBUCKLE LIME 4330'</u>
	4328	4337	Set and cemented 5 1/2" OD, 17# 8R thd., R-1, So. Chester L.W. steel casing (A cond.) at 4337' with 200 sacks of Pozmix cement. Ran Halliburton Temperature Survey and found top of cement at 3125'.
			Moved in and rigged up cable tools and bailed hole dry. Drilled cement plug and cleaned out to 4334'. Ran Lane-Wells Gamma Ray Survey. Drilled cement plug and cleaned out to bottom.
Shale	4337	4340	
Lime	4340	4345	Bailed and tested 3 hours, no shows
Lime	4345	4347	No shows
Sand	4347	4349	No shows
Lime and green shale	4349	4351	No shows. Bailed and tested 18 hours, no shows. Cleaned out cavings at 4351'
Gray porous dolomite	4351	4352	500' water in hole in 2 hours. Bailed and tested 9 hours, unable to lower water level. Ran 2" tubing with Halliburton DM retainer set at 4300'SLM. Cemented off open hole from 4300' to 4353' with 75 sacks of cement, maximum TP-3500#. Pulled 2" tubing. Bailed hole dry and 5 1/2" casing tested dry.
TOTAL DEPTH	4353'	PB 4300'SLM	

Perforated 5 1/2" casing from 4278' to 4289 1/2' with 71 holes by Lane-Wells. Bailed and tested 16 hours, 2 gallons of oil and 2 gallons of water per hour. Ran 2" tubing and Halliburton HM packer set at 4210'. Treated with Halliburton Sand-Oil-Frac from 4278' to 4289 1/2' as follows:

SAND-OIL-FRAC TREATMENT NO. 1 - Between 4278' and 4289 1/2'

Used 267 barrels of oil  
5000# of sand  
Maximum TP-3000#, broke to 2200#  
Time 62 minutes

Pulled tubing and packer and bailed and cleaned up hole. Swabbed through 5 1/2" casing 15 hours, 250 barrels of oil used in treating, no water. Then swabbed through 5 1/2" casing 16 hours, 17 barrels of treating oil, 106 barrels formation oil, and 9 barrels of water. Ran 2" tubing and moved out cable tools. Installed pumping equipment. On May 25, POB 14 hours, 105 barrels of oil and 7 barrels of water. On May 26, POB 24 hours, 133 barrels of oil and 8 barrels of water. On May 28, POB 24 hours, 135 barrels of oil and 8 barrels of water. Shut down for tank room.

On June 15, POB 8 hours, 59.40 barrels of oil and no water to establish 24 hour State Corporation Commission potential of 178 barrels. Allowable 25 barrels per day.

SLOPE TEST DATA: Tests were taken at 750', 1000', 1400', 1800', 2350', 2850', 3400' and 3750', with no deviation from vertical noted.

2000  
 1000  
 500  
 0  
 500  
## PLUGGING BACK RECORD

Date Commenced: May 14, 1957  
Date Completed: June 6, 1957

Plugged back from: 4300' to 4001' PB TB-4001'

Production Before: 1 barrel of oil and 1 barrel of water  
Production After: POB 24 hours, 238 barrels oil and 68 barrels water

5½" casing perforations open:

Above bridging plug: 3850'-3858' with 49 holes, 3870'-3874' with 25 holes, 3902'-3908' with 37 holes, and 3915'-3924' with 56 holes, 3950'-3956' with 37 holes, and 3988'-3998½' with 64 holes  
Below bridging plug: 4278'-4289½' with 71 holes

Producing Formation: Kansas City Lime

Moved in and rigged up cable tools of W. L. Copeland Drilling Company on May 14, 1957. Pulled rods and 2" tubing and found PB TB-4300' SLM. Swabbed through 5½" casing 3 hours, 10 barrels of oil and 10 barrels of water. Bailed and tested 9 hours, 2 gallons of water with trace of oil per hour. Ran 2" tubing and set Halliburton HM packer at 4254'. Ran Halliburton Sand-Oil-Frac treatment through perforations as follows:

SAND-OIL-FRAC TREATMENT NO. 2 - Between 4278' and 4289½'

Used 6300# of sand  
6000 gallons of heavy oil  
150 barrels of oil to fill hole and flush  
Maximum TP-6000#, minimum TP-5300#  
Time 27 minutes

Pulled 2" tubing and HM packer and swabbed through 5½" casing 17 hours, 112 barrels of oil used in treating, no water. On May 17, swabbed through 5½" casing 24 hours, 16 barrels of oil used in treating and 8 barrels of water.

Set Lane-Wells bridging plug at 4010' and plugged back from 4010' to 4004' with 1 sack of Cal-Seal. Perforated 5½" casing from 3988' to 3998½' with 64 holes by Lane-Wells. Swabbed through 5½" casing 16 hours, 50½ barrels of oil and no water. On May 19, swabbed through 5½" casing 3 hours, 10 barrels of oil and no water. Treated through 5½" casing from 3988' to 3998½' with 750 gallons of Halliburton 15% acid and 500 gallons of Halliburton HV acid as follows:

ACID TREATMENT NO. 1 - Between 3988' and 3998½'

Treatment put in 5/19/57 by Halliburton, using 750 gallons of acid and 105 barrels of oil.

TIME	CP	TP	REMARKS
11:17 pm			Start 15% acid
11:20 pm			Start HV acid
11:24 pm			Start flush
11:37 pm			Acid on bottom
11:42 pm			250 gallons of 15% acid in
11:52 pm			500 gallons of HV acid in
11:59 pm			Finished flush

Swabbed through 5½" casing 2 hours, 105 barrels of oil used in treating and 23 barrels of acid water. Then swabbed 12 hours, 167 barrels of oil and no water. On May 20, swabbed through 5½" casing 2 hours, 26½ barrels of oil and no water.

Set Lane-Wells bridging plug at 3972'. Swabbed and bailed hole dry and 5½" casing tested dry. Plugged back from 3972' to 3968' with 1/2 sack of Cal-Seal. Perforated 5½" casing from 3950' to 3956' with 37 holes by Lane-Wells; bailed and tested 3 hours, 14 gallons of oil and no water per hour. Treated through 5½" casing with 250 gallons of Halliburton HV acid as follows:

ACID TREATMENT NO. 2 - Between 3950' and 3956'

Treatment put in 5/20/57 by Halliburton, using 250 gallons of acid and 96 barrels of oil.

TIME	CP	TP	REMARKS
6:00 pm	Vac.		Start acid
6:22 pm	1000		Acid on bottom
6:28 pm	1000		
6:29 pm	1100		
6:32 pm	1000		
6:34 pm	1050		250 gallons of acid in

Swabbed through 5½" casing 3 hours, 96 barrels of oil used in treating and 23 barrels of acid water; then swabbed 2 hours, 21 barrels of formation oil and no water. On May 21, swabbed through 5½" casing 3 hours, 24 barrels of formation oil, no water.

Loaded hole with 50 barrels of oil. Drilled and drove Lane-wells bridging plug from 3972' to 4002'. Swabbed through 5½" casing 2 hours, 50 barrels of oil used to load hole; then swabbed 11 hours, 187 barrels of formation oil and 5 barrels of water. On May 22, swabbed through 5½" casing 3 hours, 29 barrels of oil and no water.

Set Lane-wells bridging plug at 3942'. Swabbed hole dry and 5½" casing tested dry. Plugged back from 3942' to 3932' with 1 sack of Cal-Seal. Perforated 5½" casing from 3915' to 3924' with 56 holes by Lane-wells; bailed and tested 2 hours, no shows. Perforated 5½" casing from 3902' to 3908' with 37 holes by Lane-wells; bailed and tested 2 hours, 14 gallons of oil and 1 gallon of water. Ran 2" tubing and set HM pecker at 3912'. Treated from 3915' to 3924' with 250 gallons of Halliburton 15% acid and 500 gallons of Halliburton HV acid as follows:

ACID TREATMENT NO. 3 - Between 3915' and 3924'

Treatment put in 5/22/57 by Halliburton, using 750 gallons of acid.

TIME	CP	TP	REMARKS
9:25 pm		Vac.	Start 15% acid
9:32 pm		750	Acid on bottom
9:37 pm		1750	250 gallons of 15% acid in
9:39 pm		900	250 gallons HV acid in
9:41 pm		950	500 gallons HV acid in

Then treated through 5½" casing from 3902' to 3908' with 250 gallons of Halliburton 15% acid and 500 gallons of Halliburton HV acid as follows:

ACID TREATMENT NO. 4 - Between 3902' and 3908'

Treatment put in 5/22/23/57 by Halliburton, using 750 gallons of acid and 70 barrels of oil.

TIME	CP	TP	REMARKS
9:50 pm		Vac.	Start 15% acid
10:05 pm		850	Acid on bottom
1:16 am		800	
1:29 am		800	
1:46 am		900	500 gallons HV acid in
1:59 am		900	Finished flush

Swabbed through 2" tubing 3 hours from 3915' to 3924', 20 barrels of oil used in treating and 9 barrels of acid water. On May 23, swabbed through 2" tubing 24 hours from 3915' to 3924', 165 barrels of formation oil, 9 barrels of acid water, and 3 barrels of formation water. Pulled 2" tubing and HM packer, and swabbed through 5½" casing 2 hours, 70 barrels of oil used in treating and 18 barrels of acid water; then swabbed 7 hours, 105 barrels of formation oil and 5 barrels of water.

Loaded hole with 50 barrels of oil. Drilled and drove Lane-wells plug from 3942' to 4000'. Swabbed through 5½" casing 1 hour, 50 barrels of oil used to load hole. Then swabbed 6 hours, 81 barrels of oil and 2 barrels of water.

Set Lane-wells bridging plug at 3885' and plugged back from 3885' to 3883' with 1/4 sack of Cal-Seal. Perforated 5½" casing from 3870' to 3874' with 25 holes by Lane-wells; bailed and tested 1 hour, no recovery. Perforated 5½" casing from 3850' to 3858' with 49 holes by Lane-wells; bailed and tested 2 hours, 1 gallon of drilling mud. Ran 2" tubing and set Halliburton HM packer at 3865'. Treated through 2" tubing with 250 gallons of Halliburton 15% acid and 500 gallons of HV acid as follows:

ACID TREATMENT NO. 5 - Between 3870' and 3874'

Treatment put in 5/25/57 by Halliburton, using 750 gallons of acid.

TIME	CP	TP	REMARKS
11:00 pm			Start acid
11:13 pm		300	Acid on bottom
11:16 pm		800	250 gallons 15% acid in
11:20 pm		1800	
11:31 pm		900	500 gallons HV acid in

Then treated down annulus from 3850' to 3858' with 250 gallons of Halliburton 15% acid and 500 gallons of HV acid as follows:

ACID TREATMENT NO. 6 - Between 3850' and 3858'

Treatment put in 5/26/57 by Halliburton, using 750 gallons of acid and 70 barrels of oil.

TIME	CP	TP	REMARKS
12:10 am		Vac.	Start acid
12:50 am		900	250 gallons of 15% acid in
1:10 am		1400	84 gallons HV acid in
1:30 am		1400	500 gallons of HV acid in

Swabbed through 2" tubing 2 hours, 20 barrels of oil used in treating and 10 barrels of acid water. On May 26, swabbed through 2" tubing 20 hours, 115 barrels of formation oil, 8 barrels of acid water, and 22 barrels of formation water. Pulled 2" tubing and HM packer, then swabbed through 5½" casing 2 hours, 70 barrels of oil used in treating and 18 barrels of acid water. Then swabbed 14 hours, 95 barrels of formation oil and 43 barrels of water.