

STATE OF KANSAS
STATE CORPORATION COMMISSION


WELL PLUGGING RECORD

Give All Information Completely
Make Required Affidavit
Mail or Deliver Report to:
Conservation Division
State Corporation Commission
800 Bitting Building
Wichita, Kansas

FORMATION PLUGGING RECORD

Strike out upper line
when reporting plug-
ging of formations.

NORTH

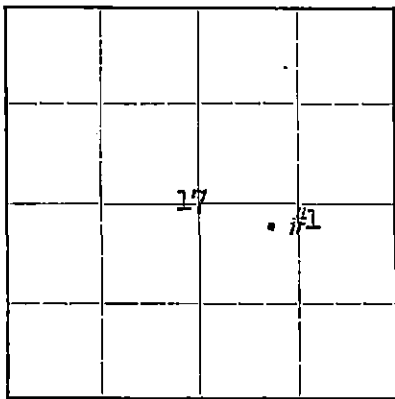

Locate well correctly on above
Section Plat

Reno County. Sec. 17 Twp. 24 Rge. (E) 8 (W)
Location as "NE 1/4 NW 1/4 SW 1/4" or footage from lines NE 1/4 NW 1/4 SE 1/4
Lease Owner Cities Service Oil Company
Lease Name Morton "B" Well No. 1
Office Address Bartlesville, Oklahoma
Character of Well (completed as Oil, Gas or Dry Hole) Dry Hole
Date well completed August 28, 1942
Application for plugging filed August 28, 1942
Application for plugging approved August 28, 1942
Plugging commenced August 28, 1942
Plugging completed August 28, 1942
Reason for abandonment of well or producing formation Dry Hole
If a producing well is abandoned, date of last production 19
Was permission obtained from the Conservation Division or its agents before plugging was com-
menced? Yes

Name of Conservation Agent who supervised plugging of this well Ruel Durkee
Producing formation Depth to top Bottom Total Depth of Well 3865 Feet
Show depth and thickness of all water, oil and gas formations.

OIL, GAS OR WATER RECORDS

CASING RECORD

Formation	Content	From	To	Size	Put In	Pulled Out
				8-5/8"	200'	None

Describe in detail the manner in which the well was plugged, indicating where the mud fluid was placed and the method or methods used in introducing it into the hole. If cement or other plugs were used, state the character of same and depth placed, from feet to feet for each plug set.

Hole was circulated with heavy mud from total depth; a permanent bridge was placed 200 ft. with 10 sacks of cement; hole was filled with mud to 20 ft.; a permanent bridge placed at 20 ft. with 10 sacks of cement, and mudded to surface.

pd
9/24/42
Ha

PLUGGING
FILE REC. 17-24R-8W
BOOK PAGE 48 LINE 35

RECD
10-12-42

(If additional description is necessary, use BACK of this sheet)

Correspondence regarding this well should be addressed to R. C. Hauber
Address Box 751, Great Bend, Kansas

STATE OF Kansas, COUNTY OF Barton, ss.
J. A. Deffeyes (employee of owner) or (owner or operator) of the above-described well,
being first duly sworn on oath, says: That I have knowledge of the facts, statements, and matters herein contained and the log of the above-described well as filed and that the same are true and correct. So help me God.

(Signature) [Signature]
Box 751, Great Bend, Kansas (Address)

SUBSCRIBED AND SWORN to before me this 7 day of October, 1942

My Commission Expires Sept. 26, 1946

My commission expires

Notary Public.



WELL RECORD

Company Cities Service Oil Co. Well No. 1 Farm Morton "B"
 Location 330' south & 990' east of Center Sec. 17 T. 24 R. 8W
 Elevation 1659 County Reno State Kansas
 Drlg. Comm. August 8, 1942 Contractor Earl F. Wakofield
 Drlg. Comp. August 23, 1942 Acid None
 T. D. 3865' Initial Prod. Dry - Plugged and Abandoned

CASING RECORD:

8-5/8" @ 200' con. 125 sx Lone Star


FORMATION RECORD:

surface clay	0-30
sand	80
red rock	200
red rock & shale	645
anhydrite	648
shale & shells	980
salt & shale	1150
lime broken	1553
lime sandy	1596
lime broken	1649
shale & shells	1665
lime	1693
lime broken	1761
lime & shale	1812
lime broken	1835
shale & shells	1690
lime	1905
red rock & lime	1918
lime broken	2020
shale & shells	2145
lime broken	2203
shale & shells	2278
lime	2285
lime broken	2396
lime & shale	2555
lime sandy	2570
lime	2630
lime broken	2693
lime	2972
sandy shale	3050
shale & shells	3139
shale	3145
sandy lime	3173
lime	3228
lime broken	3265
lime & chert	3293
lime	3465
lime & shale streaks	3491
lime broken	3515

lime & shale	3576
shale with lime streaks	3607
shale & lime	3637
shale	3704
lime & sand	3721
shale	3726
lime	3753
shale	3760 -
sand	3771
hard sand & shale	3783
shale & shells	3812
shale & sand	3835
lime	3865 T. D.

Top Lansing	3155'
Top Viola	3725'
Top Simpson	3756'
Top Arbuckle	3835'
Penetration	30'
Total Depth	3865'

Slope Test: 700' 0°
 1375' 0°
 1900' 0°
 2500' 0°
 3000' 1/2°

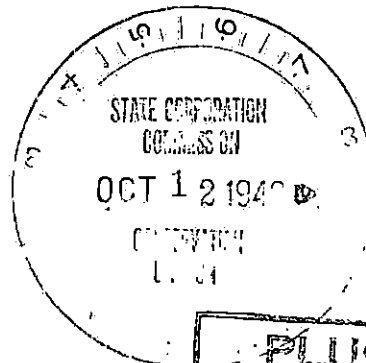

PLUGGING
 FILE REC 17-24-R-8W
 BOOK PAGE 48 LINE 35