

STATE OF KANSAS
STATE CORPORATION COMMISSION


WELL PLUGGING RECORD

Give All Information Completely
Make Required Affidavit
Mail or Deliver Report to:
Conservation Division
State Corporation Commission
212 North Market, Insurance Bldg.
Wichita, Kansas

Reno County, Sec. 17 Twp. 24S Rge. 8 (E) W (W)

Location as "NE/CNW/SW" or footage from lines SW N E NE
Lease Owner George B. Siegrist
Lease Name Morton Well No. 1
Office Address Box 1052 - Hutchinson, Kansas
Character of Well (completed as Oil, Gas or Dry Hole) Dry Hole
Date well completed April 8 1960
Application for plugging filed April 8 1960
Application for plugging approved April 8 1960
Plugging commenced April 8 1960
Plugging completed April 8 1960
Reason for abandonment of well or producing formation Dry Hole

NORTH

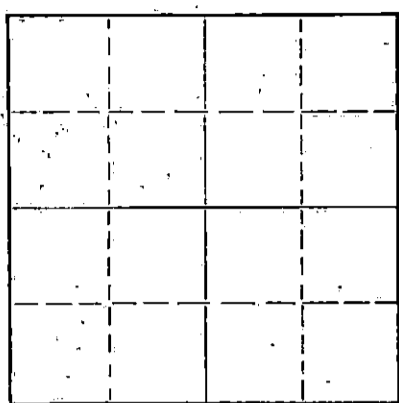

Locate well correctly on above Section Plat

If a producing well is abandoned, date of last production _____ 19____
Was permission obtained from the Conservation Division or its agents before plugging was commenced? yes

Name of Conservation Agent who supervised plugging of this well Fred Hampel
Producing formation _____ Depth to top _____ Bottom _____ Total Depth of Well 3751 Feet
Show depth and thickness of all water, oil and gas formations.

OIL, GAS OR WATER RECORDS

CASING RECORD

FORMATION	CONTENT	FROM	TO	SIZE	PUT IN	PULLED OUT
		0	unknown 165'	8 5/8"	unknown 165'	none

Describe in detail the manner in which the well was plugged, indicating where the mud fluid was placed and the method or methods used in introducing it into the hole. If cement or other plugs were used, state the character of same and depth placed, from _____ feet to _____ feet for each plug set.

From 3751' to 160' - heavy rotary mud
160' to 98' - plug, 1/4 sk hulls & 20 sks cement
98' to 40' - heavy rotary mud
40' to 6' - plug, 1/4 sk hulls & 10 sks cement
6' to 0 - cellar
- 2 sks in rot. hole

RECEIVED
STATE CORPORATION COMMISSION
APR 19 1960
4-19-60
CONSERVATION DIVISION
Wichita, Kansas

(If additional description is necessary, use BACK of this sheet)
Name of Plugging Contractor Peel Brothers, Inc.
Address P.O. Box 359 - Hoisington, Kansas

STATE OF KANSAS COUNTY OF BARTON, ss.
Peel Brothers, Inc. (employee of owner) or (owner or operator) of the above-described well, being first duly sworn on oath, says: That I have knowledge of the facts, statements, and matters herein contained and the log of the above-described well as filed and that the same are true and correct. So help me God, PEEL BROTHERS, INC.

(Signature) BY: [Signature]
P.O. Box 359 - Hoisington, Kansas
(Address)

SUBSCRIBED AND SWORN TO before me this 13 day of April, 1960

My commission expires April 27, 1960 [Signature] Notary Public.

DRILLERS' LOG

Well Owner: George B. Siegrist
Farm Name: Morton Well #1
Total Depth: 3751'
Commenced: 3/30/60
Completed: 4/8/60
Casing: 8 5/8" c. 165' con.
Contractor: Peel Brothers, Inc.

SW NE NE
Sec. 17-Twp 24S-Rge 8W
Reno County, Kansas
Elevation:
Production: Dry

Figures below indicate bottoms of formations:

Red Bed and shale	165-	-460
Shale and shells		1200
Lime and shale		1315
Lime		1715
Shale and lime		2500
Lime		2560
Lime and shale		3202
Lime		3555
Lime and shale		3740
Lime		3751
T.D.		3751

This is to certify that the above information is to the best of our knowledge, true and correct.

PEEL BROTHERS, INC.

BY Wendell G. Cook

SUBSCRIBED AND SWORN to before me this 23 day of April, 1960.

My commission expires: April 27, 1960.

Ruth Brant
Notary Public

RECEIVED
STATE CONSERVATION COMMISSION
APR 19 1960
CONSERVATION DIVISION
Wichita, Kansas