

STATE OF KANSAS
STATE CORPORATION COMMISSION

WELL PLUGGING RECORD

Give All Information Completely
Make Required Affidavit
Mail or Deliver Report to
Conservation Division
State Corporation Comm.
245 North Water
Wichita, KS 67202.

Reno County, Sec. 4 Twp. 24S Rge. 9 EXW
Location as "NE/CNW $\frac{1}{4}$ /SW $\frac{1}{4}$ " or footage from lines
CW/2 SW SE

Lease Owner William Blaser
Lease Name Kimple Well No. 1A
Office Address 800 South Broadway, Ste. 6, Wichita, KS 67211
Character of Well (Completed as Oil, Gas or Dry Hole)
Dry Hole

Date Well completed 5/16 1979
Application for plugging filed 5/16 1979
Application for plugging approved 5/16 1979
Plugging commenced 5/16 1979
Plugging completed 5/16 1979


Reason for abandonment of well or producing formation
Dry Hole

If a producing well is abandoned, date of last production
19

Was permission obtained from the Conservation Division or
its agents before plugging was commenced? yes

Name of Conservation Agent who supervised plugging of this well Gilbert Toman
Producing formation Depth to top Bottom Total Depth of Well

Show depth and thickness of all water, oil and gas formations.

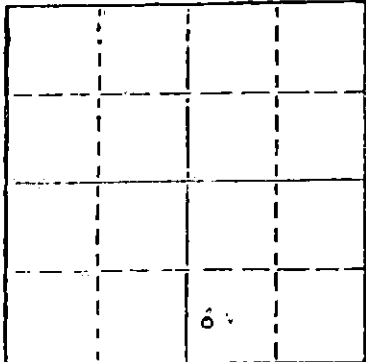

Locate well correctly on above
Section Plat

OIL, GAS OR WATER RECORDS

CASING RECORD

FORMATION	CONTENT	FROM	TO	SIZE	PUT IN	PULLED OUT

Describe in detail the manner in which the well was plugged, indicating where the mud fluid was placed and the method or methods used in introducing it into the hold. If cement or other plugs were used, state the character of same and depth placed, from 500 feet to 40 feet for each plug set.

Set first plug 400' with 40 sacks cement through the drill pipe. Set middle plug at 225' with 25 sacks cement through the drill pipe. Set top plug at 40' with 1/2 sack hulls and 10 sacks cement. Put 2 sacks cement in rat hole.

Plugging contractor--Duke Drilling

RECEIVED
STATE CORPORATION COMMISSION
JUN 2 1979
Rec'd 6-20-79
RECEIVED
CONSERVATION DIVISION
Wichita, Kansas
JUN 2 1979
RECEIVED
CONSERVATION DIVISION
Wichita, Kansas

(If additional description is necessary, use BACK of this sheet)

Name of Plugging Contractor Duke Drilling

STATE OF Kansas COUNTY OF Sedgwick, ss.
Jack Carindes of United Energy Inc. (employee of owner) or (owner or operator)
of the above-described well, being first duly sworn on oath, says: That I have knowledge of the facts, statements, and matters herein contained and the log of the above-described well as filed and that the same are true and correct. So help me God.

(Signature) Jack Carindes

SUBSCRIBED AND SWORN TO before me this 18th day of July, 1979.

(Address)
Kathy Faye Blick
Notary Public.

My commission expires October 29, 1982

