


STATE OF KANSAS
STATE CORPORATION COMMISSION

WELL PLUGGING RECORD

Give All Information Completely
Make Required Affidavit
Mail or Deliver Report to
Conservation Division
State Corporation Comm.
245 North Water
Wichita, KS 67202

Reno County. Sec. 4 Twp. 24 Rge. 9W E/W
Location as "NE/CNW $\frac{1}{4}$ SW $\frac{1}{4}$ " or footage from lines _____

C SE NW
Lease Owner National Crude Inc.
Lease Name _____ Dale _____ Well No. 1
Office Address 7701 E. Kellog Wichita Ks.
Character of Well (Completed as Oil, Gas or Dry Hole) _____

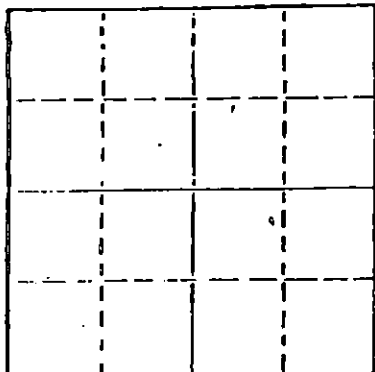

Locate well correctly on above Section Plot

Dry hole (gas)
Date Well completed 6/ 1978
Application for plugging filed 11/10 1978
Application for plugging approved 11/13 1978
Plugging commenced 11/20 1978
Plugging completed 11/30 1978
Reason for abandonment of well or producing formation _____

Dry
If a producing well is abandoned, date of last production _____

None 19
Was permission obtained from the Conservation Division or its agents before plugging was commenced? Yes

Name of Conservation Agent who supervised plugging of this well Gilbert Toman
Producing formation Cherokee Depth to top 3800 Bottom _____ Total Depth of Well 3814
Show depth and thickness of all water, oil and gas formations.

OIL, GAS OR WATER RECORDS

CASING RECORD

FORMATION	CONTENT	FROM	TO	SIZE	PUT IN	PULLED OUT
	Surface	0	210	8 5/8		
		0	3814	5 1/2		2123.

Describe in detail the manner in which the well was plugged, indicating where the mud fluid was placed and the method or methods used in introducing it into the hold. If cement or other plugs were used, state the character of same and depth placed, from _____ feet to _____ feet for each plug set.

Filled hole with sand to 3750 dumped 4 sx. cement,

Pumped in 3 sx. hlls 20 sx. jell, and 85 sx. 50-50 poz. cement with Sun cementers

RECEIVED
STATE CORPORATION COMMISSION
12-4-78
DEC - 4 1978

CONSERVATION DIVISION
Wichita, Kansas


(If additional description is necessary, use BACK of this sheet)

Name of Plugging Contractor Nicholas casing Pulling
Box 373 Geneseo Kans. 67444

STATE OF Kansas COUNTY OF Rice, ss.
(employee of owner) or (owner or operator)
of the above-described well, being first duly sworn on oath, says: That I have knowledge of the facts, statements, and matters herein contained and the log of the above-described well as filed and that the same are true and correct. So help me God.

(Signature) George A. Nicholas

(Address) _____

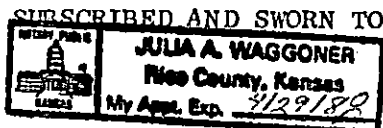

My commission expires April 29, 1980

Julia A. Waggoner
Notary Public.