


STATE OF KANSAS
STATE CORPORATION COMMISSION

WELL PLUGGING RECORD

Give All Information Completely
Make Required Affidavit
Mail or Deliver Report to:
Conservation Division
State Corporation Commission
212 North Market, Insurance Bldg.
Wichita, Kansas

NORTH

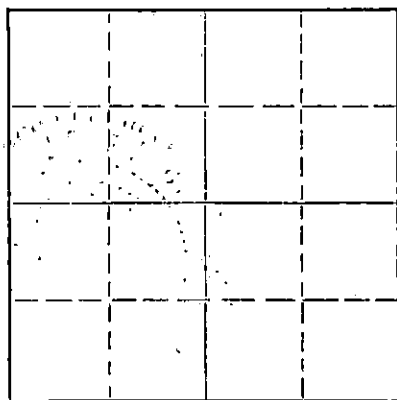

Locate well correctly on above
Section Plat

Reno County, Sec. 4 Twp. 24S Rge. 9 XXXX (W)
Location as "NE/CNW/SW" or footage from lines C-SW/4 SW/4
Lease Owner Olympic Petroleum Company
Lease Name Melville, Davidson Well No. 1
Office Address 204 Columbia Bldg., Tulsa, Oklahoma
Character of Well (completed as Oil, Gas or Dry Hole) Dry
Date well completed November 16, 1963
Application for plugging filed 19
Application for plugging approved 19
Plugging commenced November 16, 1963
Plugging completed November 16, 1963
Reason for abandonment of well or producing formation Dry

If a producing well is abandoned, date of last production 19
Was permission obtained from the Conservation Division or its agents before plugging was commenced?

Name of Conservation Agent who supervised plugging of this well Gilbert J. Toman, Holyrood, Kansas
Producing formation Depth to top Bottom Total Depth of Well Feet
Show depth and thickness of all water, oil and gas formations.

OIL, GAS OR WATER RECORDS

CASING RECORD

FORMATION	CONTENT	FROM	TO	SIZE	PUT IN	PULLED OUT
Clay		0	35			
Sand		35	100			
Shale & Shells		100	202	8 5/8	202 ft.	None

Describe in detail the manner in which the well was plugged, indicating where the mud fluid was placed and the method or methods used in introducing it into the hole. If cement or other plugs were used, state the character of same and depth placed, from feet to feet for each plug set.

Filled hole with mud to 195 ft., built bridge with 1/2 sack hulls & cemented with 20 sacks cement. Filled hole to 40 ft. with mud. Built bridge with 1/2 sack hulls, halliburton plug, 1/2 sack hulls and 10 sacks cement. 2 sacks cement in rathole. Plugging completed at 1:00 P.M., November 16, 1963.

RECEIVED
STATE CORPORATION COMMISSION
11-27-63
NOV 27 1963

CONSERVATION DIVISION
Wichita, Kansas

(If additional description is necessary, use BACK of this sheet)
Name of Plugging Contractor Blackstone Drilling, Inc.
Address Box # 455, McPherson, Kansas

STATE OF Kansas, COUNTY OF McPherson, ss.

James E. Silver (employee of owner) of the above-described well, being first duly sworn on oath, says: That I have knowledge of the facts, statements, and matters herein contained and the log of the above-described well as filed and that the same are true and correct. So help me God.

(Signature)

James E. Silver

204 Columbia Bldg., Tulsa, Oklahoma
(Address)

SUBSCRIBED AND SWORN to before me this 26 day of November, 1963

My commission expires

July 23, 1967

Laney L. Shannon

Notary Public.



Blackstone Drilling, Inc.

Box 455 • 523 West Kansas • Phone CH 1-1250

McPHERSON • KANSAS

November 18, 1963

COMPANY: OLYMPIC PETROLEUM COMPANY
CONTRACTOR: BLACKSTONE DRILLING, INC.
FARM: MELVILLE DAVIDSON #1
LOCATION: C-SW/4 SW/4, Sec. 4-24S-9W,
Reno County, Kansas
COMMENCED: November 7, 1963
COMPLETED: November 16, 1963
ELEVATION: 1700 K. B.

0	to	35	Clay
35	to	100	Sand
100	to	1370	Shale & Shells
1370	to	2020	Lime & Shale
2020	to	2145	Lime
2145	to	2215	Lime & Shale
2215	to	2375	Shale & Lime
2375	to	2500	Lime
2500	to	2955	Lime & Shale
2955	to	3024	Lime
3024	to	3070	Shale & Lime
3070	to	3375	Lime & Shale
3375	to	3425	Lime
3425	to	3490	Lime & Shale
3490	to	3782	Lime
3782	to	3788	Mississippi Chert
3788	to	3830	Mississippi
		3830	T. D.

RECEIVED
STATE CORPORATION COMMISSION

NOV 27 1963

CONSERVATION DIVISION
Wichita, Kansas

Cut 12 1/4 in. hole to 202 ft. and run 204 ft. of 8 5/8 in. surface pipe and cemented on bottom at 202 ft. with 175 sacks cement. Plug down at 6:00 P.M. November 7, 1963. Cut 7 7/8 in. hole to 3830 ft. Hole Dry and Abandoned. Filled hole with mud to 195 ft., built bridge with 1/2 sack hulls, Halliburton plug, 1/2 sack hulls & cemented with 20 sacks cement. Filled hole to 40 ft. with mud. Built bridge with 1/2 sack hulls, halliburton plug, 1/2 sack hulls and 10 sacks cement. 2 sacks cement in rathole. Plugging completed at 1:00 P.M., November 16, 1963, by Gilbert J. Toman, State Plugger, Holyrood, Kansas.

TOPS: Heebner - 3110' Douglas - 3134' Brown Lime - 3278' Lansing - 3309'
Base of Kansas City - 3660' Conglomerate - 3756' Mississippi - 3769'

Measurements taken from K. B.

CERTIFICATE

I, H. J. Plouffe, President of Blackstone Drilling, Inc. do hereby certify that the above and foregoing is a true and correct copy of log on your Mellville Davidson #1, located on the C-SW SW of Sec. 4-24S-9W, Reno County, Kansas, as reflected by the files of Blackstone Drilling, Inc.

H. J. Plouffe, President

Subscribed and sworn to before me a notary public within and for McPherson County, Kansas this 18th day of November, 1963.

Ruth McVay - Notary Public

My Commission Expires: December 18, 1963.