

STATE OF KANSAS  
STATE CORPORATION COMMISSION

WELL PLUGGING RECORD


OR  
FORMATION PLUGGING RECORD

Strike out upper line  
when reporting plugging  
off formations.

Give All Information Completely  
Make Required Affidavit  
Mail or Deliver Report to:  
Conservation Division  
State Corporation Commission  
800 Bitting Building  
Wichita, Kansas

Reno County. Sec. 5 Twp. 24 S Rge. 10 (E) 10 (W)  
Location as "NE 1/4 NW 1/4 SW 1/4" or footage from lines: SW 1/4 NE 1/4 SW 1/4  
Lease Owner: Viersen & Cochran  
Lease Name: McNickle Well No. 3  
Office Address: P. O. Box 280, Okmulgee, Oklahoma  
Character of Well (completed as Oil, Gas or Dry Hole): Dry hole  
Date well completed: 10-16 19 44  
Application for plugging filed: 10-18 19 44  
Application for plugging approved: 10-18 19 44  
Plugging commenced: 10-18 19 44  
Plugging completed: 10-18 19 44  
Reason for abandonment of well or producing formation: Dry hole

NORTH

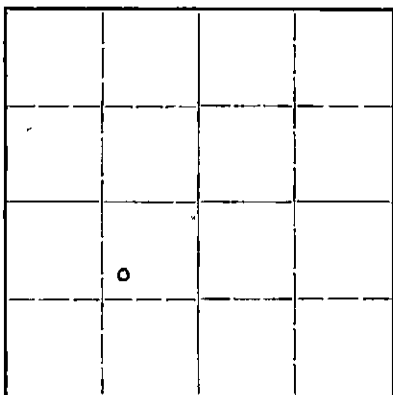

Locate well correctly on above  
Section Flat

If a producing well is abandoned, date of last production: 19  
Was permission obtained from the Conservation Division or its agents before plugging was commenced? Yes

Name of Conservation Agent who supervised plugging of this well: H. W. Kerr, Great Bend, Kansas  
Producing formation: Depth to top: Bottom: Total Depth of Well: Feet  
Show depth and thickness of all water, oil and gas formations.


OIL, GAS OR WATER RECORDS

CASING RECORD

Formation	Content	From	To	Size	Put In	Pulled Out
Misener	Dry	3746	3754	10-3/4" OD	280'	None
Fernvale Viola	Dry	3754	3763			

Describe in detail the manner in which the well was plugged, indicating where the mud fluid was placed and the method or methods used in introducing it into the hold. If cement or other plugs were used, state the character of same and depth placed, from feet to feet for each plug set.

Hole was filled with heavy mud-laden fluid to base of surface string. Balance of hole cemented and plugged in accordance with regulations and instructions.

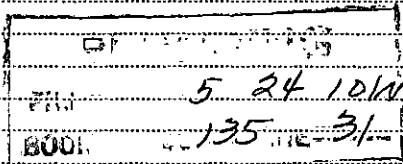

(If additional description is necessary, use BACK of this sheet)

Correspondence regarding this well should be addressed to: Viersen & Cochran  
Address: P. O. Box 280, Okmulgee, Oklahoma

STATE OF OKLAHOMA, COUNTY OF OKMULGEE, ss.  
J. A. Mock, Agent, (employee of owner) or (owner or operator) of the above-described well,  
being first duly sworn on oath, says: That I have knowledge of the facts, statements, and matters herein contained and the log of the above-described well as filed and that the same are true and correct. So help me God.

(Signature) J. A. Mock, Agent

Box 280, Okmulgee, Oklahoma (Address)

NOV November 8, 1944

Conservation Division Notary Public

SUBSCRIBED AND SWORN to before me this 6 day of

My commission expires 2-19-1945

Rec'd 11-8-44

D R I L L E R ' S   L O G

VIERSEN & COCHRAN - McNICKLE #3

Commenced drilling: 9-23-44  
Completed drilling: 10-16-44

Location: SW $\frac{1}{4}$  NE $\frac{1}{4}$  SW $\frac{1}{4}$  Section 5-24S-10W,  
Reno County, Kansas

Total Depth: 3864'      D & A

FORMATION	TOP	BOTTOM
Surface	0	30
Sand	30	150
Shale	150	280
Red shale & broken lime	280	500
Shale	500	880
Shells and shale	880	1150
Salt	1150	1340
Broken lime shells	1340	1425
Lime, broken	1425	1780
Sandy lime	1780	1840
Lime	1840	2115
Shale and lime	2115	2440
Shale and lime shells	2440	2595
Shale and lime	2595	2645
Lime	2645	2770
Lime and shale	2770	2955
Lime	2955	3235
Shale	3235	3260
Lime	3260	3290
Shale	3290	3318
Lime	3318	3320
Shale	3320	3334
Shale and lime	3334	3370
Lime	3370	3472
Lime and chert	3472	3530
Lime	3530	3639
Shale	3639	3657
Shale, lime & chert	3657	3677
Chert	3677	3717
Chert and shale	3717	3725
Shale	3725	3864
T. D.	3864	

5 24-10W  
 135-31

