


STATE OF KANSAS
STATE CORPORATION COMMISSION
Give All Information Completely
Make Required Affidavit
Mail or Deliver Report to:
Conservation Division
State Corporation Commission
800 Bitting Building
Wichita, Kansas

WELL PLUGGING RECORD

RENO County. Sec. 5 Twp. 24S Rge. 10 (E) 10 (W)
Location as "NE/CNW&SW" or footage from lines C NW NW
Lease Owner SHELL OIL COMPANY
Lease Name E. PAINE Well No. 1
Office Address BOX 744, GREAT BEND, KANSAS
Character of Well (completed as Oil, Gas or Dry Hole) OIL
Date well completed AUGUST 18 19 43
Application for plugging filed DECEMBER 22 19 52
Application for plugging approved DECEMBER 31 19 52
Plugging commenced JANUARY 16 19 53
Plugging completed JANUARY 21 19 53
Reason for abandonment of well or producing formation OIL DEPLETED

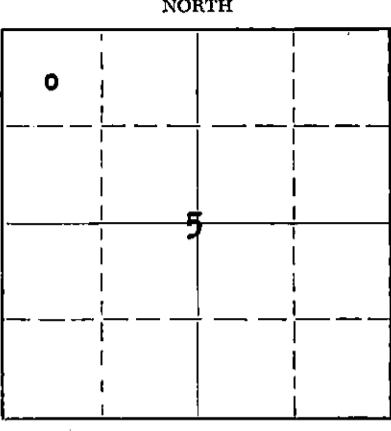

Locate well correctly on above Section Plat

If a producing well is abandoned, date of last production JUNE 1 19 52
Was permission obtained from the Conservation Division or its agents before plugging was commenced? YES

Name of Conservation Agent who supervised plugging of this well RUEL DURKEE
Producing formation VIOLA Depth to top 3676 Bottom _____ Total Depth of Well 3717 Feet
Show depth and thickness of all water, oil and gas formations. P.B. 3463

OIL, GAS OR WATER RECORDS				CASING RECORD		
FORMATION	CONTENT	FROM	TO	SIZE	PUT IN	PULLED OUT
<u>ARBUCKLE</u>	<u>I.P. 3000 oil & O water, flowing.</u>	<u>3697</u>	<u>3717</u>	<u>8 5/8"</u> <u>4 1/2"</u>	<u>287'</u> <u>3697</u>	<u>None</u> <u>1192'</u>
<u>LANSING-KANSAS CITY</u>	<u>I.P. no oil & 17 gal. water/hour, bailing. 3434-42.</u>	<u>3434</u>	<u>3442</u>			

Describe in detail the manner in which the well was plugged, indicating where the mud fluid was placed and the method or methods used in introducing it into the hole. If cement or other plugs were used, state the character of same and depth placed, from _____ feet to _____ feet for each plug set.

SET BAKER GIBP AT 3487. PB WITH CALSEAL TO 3476. PB TO 3463 WITH 1 SACK CALSEAL.

FILLED HOLE WITH SAND TO 3225 AND DUMPED 14 SACK CEMENT. FILLED HOLE WITH HEAVY MUD TO 280, SET 10' ROCK BRIDGE TO 270 AND DUMPED 15 SACK CEMENT. MUDDIED HOLE TO 30' AND CAPPED INTO BOTTOM OF CELLAR WITH 10 SACK CEMENT.

RECORDED
JAN 1 1953
REC'D 1-31-53
CONSERVATION DIVISION
Wichita, Kansas

(If additional description is necessary, use BACK of this sheet)
Name of Plugging Contractor FORBES CASING PULLING COMPANY
Address GREAT BEND, KANSAS

STATE OF KANSAS, COUNTY OF BARTON, ss.
S. S. MERRY (employee of owner) ~~or former proprietor~~ of the above-described well, being first duly sworn on oath, says: That I have knowledge of the facts, statements, and matters herein contained and the log of the above-described well as filed and that the same are true and correct. So help me God.

(Signature) S. S. Merry
BOX 744 GREAT BEND, KANSAS
(Address)

SUBSCRIBED AND SWORN TO before me this 29th day of JANUARY, 19 53

My commission expires APRIL 11, 1956 Edmont Byers, Jr. Notary Public.

PLUGGING
FILE SEC 5 T 24 R 10W
PAGE 69 LINE 20

SHELL-E. PAINE #1
C NW NW Section 5-24S-10W
Zenith-Peace Creek Field
Reno County, Kansas

CASING RECORD

8 5/8" cem 287 with 125 sax
1 1/2" cem 3697 with 800 sax; perforated 3434-42

- 0 - 98 surface soil & sand
- 178 shale, shells & redbed
- 310 red rock
- 475 redbed
- 500 anhydrite
- 1128 shale & shells
- 1338 salt & shale
- 2540 lime & shale
- 2559 shale
- 2970 lime & shale
- 3230 lime
- 3307 lime & shale
- 3462 lime
- 3500 lime & shale
- 3607 lime
- 3636 lime & chert
- 3660 lime & shale
- 3669 lime
- 3676 shale
- 3697 lime
- 3717 dolomite & chert streaks TD
- 3463 PB

Top Topeka 2822
Top Lansing-Kansas City 3312
Top Misener 3669
Top Viola 3676

RECEIVED
STATE CORPORATION COMMISSION

1-30-53

RECEIVED
STATE CORPORATION COMMISSION
DIVISION

STATE CORPORATION COMMISSION
DIVISION

PLUGGING
FILE SEC 5 T 24 R 1024
BOOK PAGE 69 LINE 30