

STATE OF KANSAS
STATE CORPORATION COMMISSION

WELL PLUGGING RECORD

Give All Information Completely
Make Required Affidavit
Mail or Deliver Report to:
Conservation Division
State Corporation Commission
800 Biting Building
Wichita, Kansas

RENO County. Sec. 5 Twp. 24S Rge. (E) 10(W)

Location as "NE/CNW4SW4" or footage from lines SW NE NW

Lease Owner SHELL OIL COMPANY

Lease Name E. PAINE Well No. 3

Office Address BOX 744, GREAT BEND, KANSAS

Character of Well (completed as Oil, Gas or Dry Hole) OIL

Date well completed NOVEMBER 1 1943

Application for plugging filed DECEMBER 22 1952

Application for plugging approved DECEMBER 31 1952


Plugging commenced JANUARY 31 1953

Plugging completed FEBRUARY 20 1953

Reason for abandonment of well or producing formation OIL DEPLETED

If a producing well is abandoned, date of last production DECEMBER 9 1951

Was permission obtained from the Conservation Division or its agents before plugging was commenced? YES

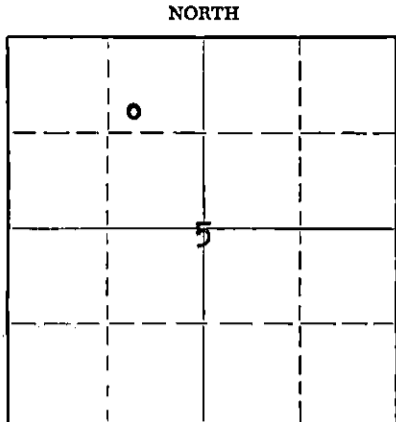

Locate well correctly on above Section Plat

Name of Conservation Agent who supervised plugging of this well RUEL DURKEE

Producing formation VIOLA Depth to top 3688 Bottom Total Depth of Well 3729 Feet

Show depth and thickness of all water, oil and gas formations.

OIL, GAS OR WATER RECORDS

CASING RECORD

FORMATION	CONTENT	FROM	TO	SIZE	PUT IN	PULLED OUT
VIOLA	I.P. 883 OIL & O WATER/24 HRS	3705	3729	8 5/8" 4 1/2"	335' 3705'	None 1025'

Describe in detail the manner in which the well was plugged, indicating where the mud fluid was placed and the method or methods used in introducing it into the hole. If cement or other plugs were used, state the character of same and depth placed, from feet to feet for each plug set.

20' OF
PLUGGED BOTTOM OF HOLE WITH SAND AND CAPPED WITH 5 SACKS OF CEMENT. FILLED HOLE WITH MUD TO 260'. SET ROCK BRIDGE AND DUMPED 15 SACKS OF CEMENT AT 245'. FILLED HOLE WITH MUD TO 25' AND CAPPED INTO CELLAR WITH 5 SACKS OF CEMENT.

RECEIVED
STATE CORPORATION COMMISSION
2-28-53 FEB 28 1953
CONSERVATION DIVISION
Wichita, Kansas

(If additional description is necessary, use BACK of this sheet)
Name of Plugging Contractor FORBES CASING PULLING COMPANY
Address GREAT BEND, KANSAS

STATE OF KANSAS COUNTY OF BARTON, ss.
S. S. MABRY (employee of owner)

well, being first duly sworn on oath, says: That I have knowledge of the facts, statements, and matters herein contained and the log of the above-described well as filed and that the same are true and correct. So help me God.

(Signature) S. S. Mabry

BOX 744, GREAT BEND, KANSAS

(Address)

SUBSCRIBED AND SWORN TO before me this 27th day of FEBRUARY, 1953

My commission expires APRIL 11, 1956

L. MONT BYERS, JR. Notary Public.

PLUGGING
FILE SEC 5 24S 10W
CORSEVA
BOOK PAGE 68 LINE 32 1/2

SHELL-E. PAINE #3
SW NE NW Section 5-24S-10W
Zenith-Peace Creek Field
Reno County, Kansas

CASING RECORD

8-5/8" cem 335 with 125 sax.
1 1/2" cem 3705 with 800 sax.

0 - 95 Sand
131 Sand & red rock
346 Red bed
717 Shale, shells & red bed
990 Shale & shells
1200 Shell & salt
1379 Shale, shells & lime
1450 Anhydrite
1622 Shale, shells & lime
3681 Lime & shale
3692 Sand & shale
3729 Lime T. D.
Top Topeka 2831
Top Lansing-Kansas City 3324
Top Misener 3677
Top Viola 3688

12-31-52

REC
STATE CORP

DEC 31 1952

CONSERVATION DIVISION
Wichita, Kansas

PLUGGING
FILE SEC 2-724 R 102
BOOK PAGE 69 LINE 32