


STATE OF KANSAS
STATE CORPORATION COMMISSION

WELL PLUGGING RECORD

Give All Information Completely
Make Required Affidavit
Mail or Deliver Report to:
Conservation Division
State Corporation Commission
800 Bittling Building
Wichita, Kansas

RENO County. Sec. 5 Twp. 24S Rge. (E) 10 (W)

Location as "NE/CNW/SW" or footage from lines. C SW NW
Lease Owner SHELL OIL COMPANY
Lease Name E. PAINE Well No. 2
Office Address BOX 744, GREAT BEND, KANSAS
Character of Well (completed as Oil, Gas or Dry Hole) OIL
Date well completed SEPTEMBER 23 19 43
Application for plugging filed DECEMBER 22 19 52
Application for plugging approved DECEMBER 31 19 52
Plugging commenced JANUARY 22 19 53
Plugging completed JANUARY 30 19 53
Reason for abandonment of well or producing formation OIL DEPLETED

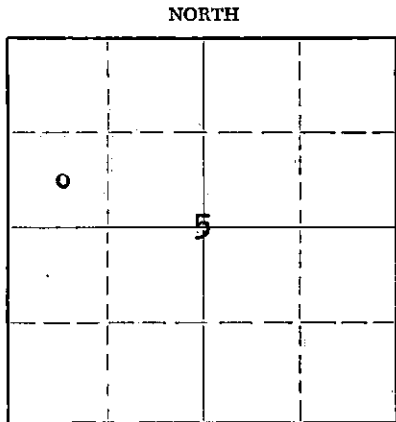

Locate well correctly on above Section Plat

If a producing well is abandoned, date of last production. OCTOBER 20 19 52
Was permission obtained from the Conservation Division or its agents before plugging was commenced? YES

Name of Conservation Agent who supervised plugging of this well RUEL DUEKKE
Producing formation VIOLA Depth to top 3686 Bottom Total Depth of Well 3728 Feet
Show depth and thickness of all water, oil and gas formations.

OIL, GAS OR WATER RECORDS

CASING RECORD

FORMATION	CONTENT	FROM	TO	SIZE	PUT IN	PULLED OUT
VIOLA	I.P. 3306 OIL & O WATER/24 HOURS, FLOWING ON BEPB TEST.	3694	3728	8 5/8" 4 1/2"	310' 3694'	None 1025'

Describe in detail the manner in which the well was plugged, indicating where the mud fluid was placed and the method or methods used in introducing it into the hole. If cement or other plugs were used, state the character of same and depth placed, from feet to feet for each plug set.

Plugged back with sand to 3685. Dumped 4 sax cement to 3647. Filled hole with heavy mud to 250'. Set 15' rock bridge to 235' and dumped 15 sax cement. Filled hole with mud to 25' and capped into cellar with 5 sax cement.

RECEIVED
STATE CORPORATION COMMISSION
FEB 4 1953
Conservation Division
Wichita, Kansas
Rec'd 2-4-53

(If additional description is necessary, use BACK of this sheet)
Name of Plugging Contractor Forbes Casing Pulling Co.
Address Great Bend, Kansas

STATE OF KANSAS COUNTY OF BARTON, ss.
S. S. MABRY (employee of owner) or ~~owner~~ operator of the above-described well, being first duly sworn on oath, says: That I have knowledge of the facts, statements, and matters herein contained and the log of the above-described well as filed and that the same are true and correct. So help me God.

(Signature) S. S. Mabry
BOX 744, GREAT BEND, KANSAS (Address)

SUBSCRIBED AND SWORN TO before me this 3rd day of FEBRUARY, 1953
L. Mont Byers, Jr. Notary Public.

My commission expires APRIL 11, 1956

PLUGGING
FILE SEC 5 T 24 R 10W
BOOK PAGE 69 LINE 31

SHELL-E. PAINE #2
C SW NW Section 5-24S-10W
Zenith-Peace Creek Field
Reno County, Kansas

CASING RECORD

8-5/8" cem 310 with 125 sax
4 1/2" cem 3694 with 800 sax

0 - 30 surface clay
165 sand & gravel
312 red rock & shale
446 red rock, shale & shells
769 shale & shells
1010 shale & anhydrite
1360 shale & salt
1565 shale & lime
1595 lime, shale & chert
1623 lime & chert
1745 lime & shale
1870 lime & chert
3364 lime & shale
3670 lime & chert
3678 sand, lime & chert
3686 sand
3728 dolomite T. D.

Top Topeka 2824
Top Lansing-Kansas City 3317
Top Misener 3678
Top Viola 3686

2-9-53

RECEIVED
STATE CORPORATION COMMISSION

FEB 9 - 1953

CONSERVATION DIVISION
Wichita, Kansas

SHELL-E. PAINE #2
C. SW. NW. Section 5-24S-10W
Zenith-Peace Creek Field
Reno County, Kansas

CASING RECORD

8-5/8" cem 310 with 125 sax
4 1/2" cem 3694 with 800 sax.

0 - 30 Surface clay
165 Sand & gravel
312 Red rock & shale
446 Red rock, shale & shells
769 Shale & shells
1010 Shale & anhydrite
1360 Shale & salt
1565 Shale & lime
1595 Lime, shale & chert
1623 Lime & chert
1745 Lime & shale
1870 Lime & chert
3364 Lime & shale
3670 Lime & chert
3678 Sand, lime & chert
3686 Sand
3728 Dolomite T. D.
Top Topeka 2824
Top Lansing-Kansas City 3317
Top Misener 3678
Top Viola 3686

This log is not completed.

Dunbar

RECEIVED
STATE CORP. & MIN. COMMISSION

2-9-53

FEB 9 - 1953
RE
STATE CONSERVATION DIVISION
Wichita, Kansas

CONSERVATION DIVISION
Wichita, Kansas

PLUGGING
WELL SEC 5-24 R 1024
BOOK PAGE 69 LINE 31