

STATE OF KANSAS  
STATE CORPORATION COMMISSION


Give All Information Completely  
Make Required Affidavit  
Mail or Deliver Report to:  
Conservation Division,  
State Corporation Commission  
800 Bitting Building  
Wichita, Kansas

WELL PLUGGING RECORD

OR  
FORMATION PLUGGING RECORD

Strike out upper line  
when reporting plugging  
of formations.

Russell County. Sec. 6 Twp. 14 Rge. (E) 15 (W)  
Location as "NE $\frac{1}{4}$ NW $\frac{1}{4}$ SW $\frac{1}{4}$ " or footage from lines SE SE NE  
Lease Owner The Phil-Han Oil Company  
Lease Name Foster-Aley Well No. 1  
Office Address 1407 Union National Bank Bldg., Wichita, Kansas  
Character of Well (completed as Oil, Gas or Dry Hole) Dry hole  
Date well completed February 19 1949  
Application for plugging filed February 19 1949  
Application for plugging approved February 19 1949  
Plugging commenced February 19 1949  
Plugging completed February 19 1949  
Reason for abandonment of well or producing formation Dry hole  
If a producing well is abandoned, date of last production 19  
Was permission obtained from the Conservation Division or its agents before plugging was commenced? Yes

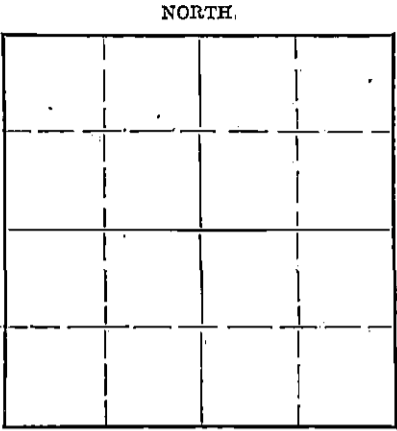

Locate well correctly on above  
Section Plat

Name of Conservation Agent who supervised plugging of this well Stough  
Producing formation Depth to top Bottom Total Depth of Well 3285' Feet  
Show depth and thickness of all water, oil and gas formations.

OIL, GAS OR WATER RECORDS

CASING RECORD

Formation	Content	From	To	Size	Put In	Pulled Out
				8 5/8"	204'	none

Describe in detail the manner in which the well was plugged, indicating where the mud fluid was placed and the method or methods used in introducing it into the hole. If cement or other plugs were used, state the character of same and depth placed, from feet to feet for each plug set.

Filled w/ heavy mud from 3285' to 204'.  
Set plug @ 204' w/ 15 sacks cement.  
Filled w/mud to 30' and cemented w/10  
sacks.

RECEIVED

Rec'd  
2-24-49

Cons.  
FEB 24 1949

STATE CORPORATION  
COMMISSION  
WICHITA, KANSAS

(If additional description is necessary, use BACK of this sheet)

Correspondence regarding this well should be addressed to The Phil-Han Oil Company  
Address 1407 Union National Bank Bldg., Wichita, Kansas

STATE OF KANSAS, COUNTY OF SEDGWICK, ss.


Perry R. Hanson (employee of owner) or (owner or operator) of the above-described well,  
being first duly sworn on oath, says: That I have knowledge of the facts, statements, and matters herein contained and the log of the above-described well as filed and that the same are true and correct. So help me God.

(Signature) Perry R. Hanson

SUBSCRIBED AND SWORN to before me this 23rd day of February, 1949

(Address) Well A. Hanson  
Notary Public.

My commission expires Oct. 4, 1949

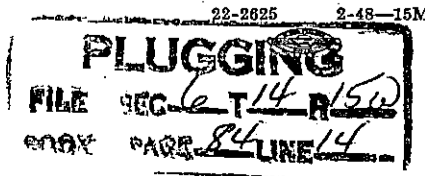

DRILLERS' LOG

#1 Foster-Aley  
The Phil-Han Oil Company

SE SE NE Sec. 6-14-15W  
Russell County, Kansas

Commenced: 2- 8-49  
Completed: 2-19-49

Prod: D & A

-----

soil and sand rock	20
shale & shells	55
shale, shells & sand	204
sand & shale	520
red rock	750
red bed	915
anhydrite	960
shale & shells	1310
shale, shells & salt	1535
shale & shells	1600
lime & shale	1810
lime	2095
lime & shale	2340
shale & lime	2475
lime & shale	2630
shale & lime	2730
lime	3000
shale	3025
lime & shale	3035
lime	3283
granite	3285
Total Depth	3285

CASING RECORD:

8 5/8" at 204' w/135 sacks.

