

STATE OF KANSAS
STATE CORPORATION COMMISSION


WELL PLUGGING RECORD

Give All Information Completely
Make Required Affidavit
Mail or Deliver Report to:
Conservation Division
State Corporation Commission
800 Bitting Building
Wichita, Kansas

OR
FORMATION PLUGGING RECORD

Strike out upper line
when reporting plug-
ging off formations.

NORTH

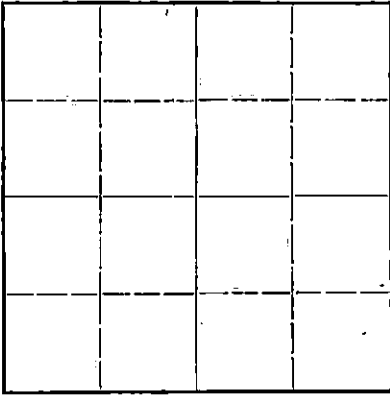

Locate well correctly on above
Section Plat

RENO County. Sec. 15 Twp. 24 Rge. 4 ~~151X~~ (W)
Location as "NE 1/4 NW 1/4 SW 1/4" or footage from lines. NW NW
Lease Owner. Jake Goldstein
Lease Name. Stone Well No. 1
Office Address. Broadview Hotel, Wichita, Kansas
Character of Well (completed as Oil, Gas or Dry Hole) Oil
Date well completed. 19
Application for plugging filed. April 24, 19 44
Application for plugging approved. April 24, 19 44
Plugging commenced. July 29, 19 44
Plugging completed. July 29, 19 44
Reason for abandonment of well or producing formation.


If a producing well is abandoned, date of last production. 19
Was permission obtained from the Conservation Division or its agents before plugging was com-
menced? Yes

Name of Conservation Agent who supervised plugging of this well. Ruel E. Durkee, McPherson, Kansas
Producing formation. Depth to top. Bottom. Total Depth of Well. 3386 Feet
Show depth and thickness of all water, oil and gas formations.

OIL, GAS OR WATER RECORDS


CASING RECORD

Formation	Content	From	To	Size	Put In	Pulled Out

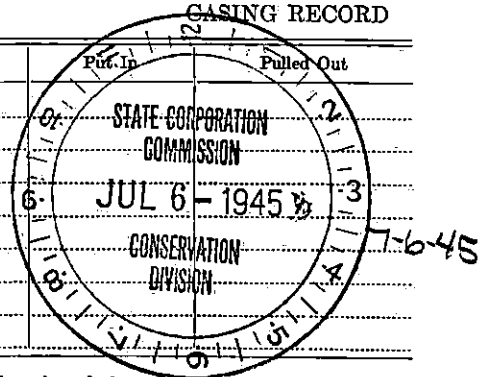

Describe in detail the manner in which the well was plugged, indicating where the mud fluid was placed and the method or methods used in introducing it into the hold. If cement or other plugs were used, state the character of same and depth placed, from feet to feet for each plug set.

8 sacks of cement at 3323'
30 sacks of cement at 350'
10 sacks of cement at base of cellar
Filled with mud between cement plugs.

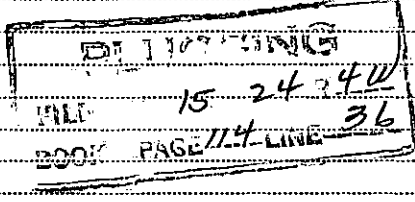

(If additional description is necessary, use BACK of this sheet)

Correspondence regarding this well should be addressed to Jake Goldstein
Address. Broadview Hotel, Wichita, Kansas

STATE OF KANSAS, COUNTY OF SEDGWICK, ss.
Jake Goldstein, ~~owner or operator~~ (owner or operator) of the above-described well,

being first duly sworn on oath, says: That I have knowledge of the facts, statements, and matters herein contained and the log of the above-described well as filed and that the same are true and correct. So help me God

(Signature) *J. Goldstein*
Broadview Hotel, Wichita, Kansas
(Address)

SUBSCRIBED AND SWORN to before me this 6th day of July, 1945
M. Helen Anderson
Notary Public.

My commission expires Nov. 5, 1947