

STATE OF KANSAS
STATE CORPORATION COMMISSION

WELL PLUGGING RECORD

Give All Information Completely
Make Required Affidavit
Mail or Deliver Report to
Conservation Division
State Corporation Comm.
245 North Water
Wichita, KS 67202

Reno County, Sec. 15 Twp. 24 Rge. 4W E/W
Location as "NE/CNW $\frac{1}{4}$ SW $\frac{1}{4}$ " or footage from lines _____

Lease Owner C. N. Nunn NE 1/4
Lease Name M.R. Allam Well No. 1


Office Address 6 Eastern Wood Hutchinson
Character of Well (Completed as Oil, Gas or Dry Hole) _____

Date Well completed July 21 1980
Application for plugging filed _____ 19____
Application for plugging approved _____ 19____
Plugging commenced 9-12- 1980
Plugging completed 9-19- 1980
Reason for abandonment of well or producing formation _____

If a producing well is abandoned, date of last production _____ 19____

Was permission obtained from the Conservation Division or its agents before plugging was commenced? Yes

Name of Conservation Agent who supervised plugging of this well Dilbert J. Moran
Producing formation _____ Depth to top _____ Bottom _____ Total Depth of Well 3375
Show depth and thickness of all water, oil and gas formations.

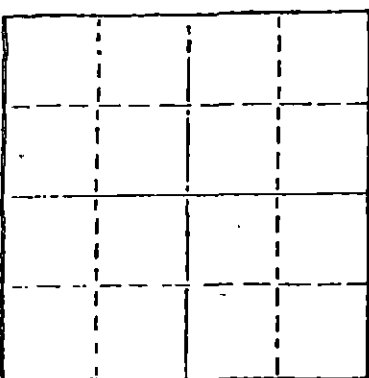


Locate well correctly on above Section Plat

OIL, GAS OR WATER RECORDS

CASING RECORD

FORMATION	CONTENT	FROM	TO	SIZE	PUT IN	PULLED OUT
				5x2		13 07 30

Describe in detail the manner in which the well was plugged, indicating where the mud fluid was placed and the method or methods used in introducing it into the hold. If cement or other plugs were used, state the character of same and depth placed, from _____ feet to _____ feet for each plug set. Push plug to bottom of well and cement plug to 3375 feet and put in five sacks of cement. Mudding hole to 290 feet and made a 15 foot rock wedge and filled with ready mix.

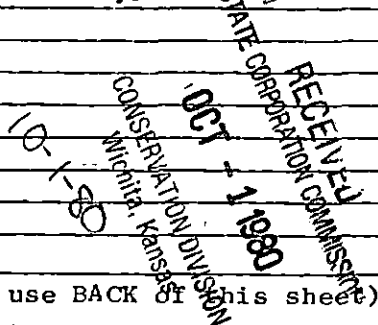

(If additional description is necessary, use BACK of this sheet)


Name of Plugging Contractor Mark J. Jerns

STATE OF Kansas COUNTY OF Reno, ss. Mark Jerns (employee of owner) or (owner or operator)

of the above-described well, being first duly sworn on oath, says: That I have knowledge of the facts, statements, and matters herein contained and the log of the above-described well as filed and that the same are true and correct. So help me God.

(Signature) Mark Jerns
8 East 3rd (Address)

SUBSCRIBED AND SWORN TO before me this 19th day of September, 1980

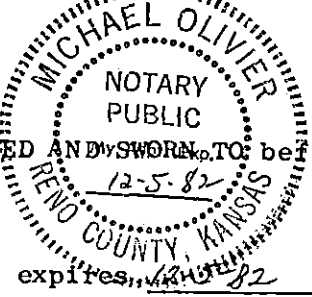

Michael Olivier Notary Public.

My commission expires 12-5-82



Blackstone Drilling, Inc.

Box 1184 • 523 West Kansas • Phone (316) 241-1250
McPHERSON, KANSAS 67460

July 23, 1979

COMPANY: W. R. ALLAM, JR.
 CONTRACTOR: BLACKSTONE DRILLING, INC.
 FARM: E. HARPER #1
 LOCATION: C NL NW/4 NE/4 Section 15-24-4W,
 Reno County, Kansas
 COMMENCED: July 7, 1979
 COMPLETED: July 21, 1979
 ELEVATION:

0	to	270	Sand & Shells
270	to	300	Blue Shale
300	to	900	Shale & Lime
900	to	1105	Lime & Shale
1105	to	2000	Shale & Lime
2000	to	2100	Topeka
2100	to	2280	Lime
2280	to	2600	Lime & Shale
2600	to	2612	Shale & Lime
2612	to	2810	Lansing
2810	to	3000	Lime
3000	to	3140	Lime & Shale
3140	to	3210	Lime
3210	to	3216	Shale
3216	to	3320	Shale & Lime
3320	to	3400	Lime
		3400	T. D.

RECEIVED
 STATE CORPORATION COMMISSION
 AUG 19 1980
 CONSERVATION DIVISION
 Wichita, Kansas

Cut 12 1/4" hole to 293' and run 295' of 8 5/8" surface pipe, cemented with 250 sacks of cement at 293'. Plug down at 11:30 A. M., July 7, 1979. Cut 7 7/8" hole to 3400'. Run 3401' of 5 1/2" casing, cemented with 75 sacks of cement at 3397', 3 feet off bottom. Plug down at 12:45 A. M., July 21, 1979.

TOPS: TOPEKA - 2000' LANSING - 2612'

Measurements taken from K. B.

CERTIFICATE

I, P. E. Plouffe, President of Blackstone Drilling, Inc. do hereby certify that the above and foregoing is a true and correct copy of log on your E. Harper #1, located on the C NL NW/4 NE/4 Section 15-24-4W, Reno County, Kansas as reflected by the files of Blackstone Drilling, Inc.


 P. E. Plouffe, President

Subscribed and sworn to before me a Notary Public in and for McPherson County, Kansas this 23rd day of July, 1979.


 Johnnie L. Schmidt - Notary Public

