


STATE OF KANSAS  
STATE CORPORATION COMMISSION  
CONSERVATION DIVISION  
P. O. BOX 17027  
WICHITA, KANSAS 67217

FORM CP-4

WELL PLUGGING RECORD

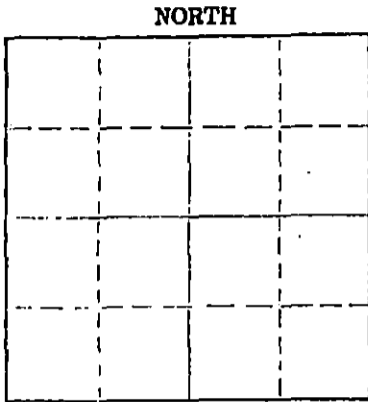

Locate well correctly on above Section Plot

Reno County. Sec. 6 Twp. 24 Rge. 10 (E) (W)  
Location as "NE/CNW&SW" or footage from lines 1320 EWL 330 NSL NW/4  
Lease Owner Stelbar Oil Corporation  
Lease Name Darr #1 Well No. \_\_\_\_\_  
Office Address Wichita, Kansas 67202  
Character of Well (completed as Oil, Gas or Dry Hole) \_\_\_\_\_  
Date well completed \_\_\_\_\_ 19\_\_\_\_  
Application for plugging filed \_\_\_\_\_ 19\_\_\_\_  
Application for plugging approved \_\_\_\_\_ 19\_\_\_\_  
Plugging commenced 4/6/76 \_\_\_\_\_ 19\_\_\_\_  
Plugging completed 4/26/76 \_\_\_\_\_ 19\_\_\_\_  
Reason for abandonment of well or producing formation depleted.

If a producing well is abandoned, date of last production \_\_\_\_\_ 19\_\_\_\_  
Was permission obtained from the Conservation Division or its agents before plugging was commenced? YES

Name of Conservation Agent who supervised plugging of this well Toman  
Producing formation \_\_\_\_\_ Depth to top \_\_\_\_\_ Bottom \_\_\_\_\_ Total Depth of Well 3783 Feet  
Show depth and thickness of all water, oil and gas formations.

OIL, GAS OR WATER RECORDS

CASING RECORD

FORMATION	CONTENT	FROM	TO	SIZE	PUT IN	PULLED OUT
				8-5/8	257	NONE
				5 1/2"	3782	2515'

Describe in detail the manner in which the well was plugged, indicating where the mud fluid was placed and the method or methods used in introducing it into the hole. If cement or other plugs were used, state the character of same and depth placed, from \_\_\_\_\_ feet to \_\_\_\_\_ feet for each plug set.

Checked bottom, ran sand to 3750' and dumped 5 sacks cement.  
Loaded hole with 80 barrels salt water, shot pipe at 3078',  
2979', 2885', 2790', 2695', 2607', 2510', pulled 82 joints.  
Allied pumped 5 sacks hulls, 25 sacks gel and 100 sacks cement.  
PLUGGING COMPLETE.

(If additional description is necessary, use BACK of this sheet)  
Name of Plugging Contractor KNIGHT CASING PULLING CO., INC.  
Address CHASE, KANSAS

STATE OF KANSAS COUNTY OF RICE  
NOEL J. KNIGHT (employee of owner) or (owner or operator) of the above-described well, being first duly sworn on oath, says: That I have knowledge of the facts, statements, and matters herein contained and the log of the above-described well as filed and that the same are true and correct. So help me God.

(Signature) Noel Knight  
CHASE, KANSAS


SUBSCRIBED AND SWORN TO before me this 28th day of April, 1976

Margaret Melcher  
Notary Public.

My commission expires



MAY 06 1976  
5-6-76  
CONSERVATION DIVISION  
Wichita, Kansas

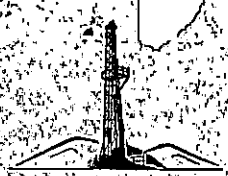

# Blackstone Drilling, Inc.

Box 455 • 523 West Kansas • Phone CH 1-1250

McPHERSON • KANSAS  
67460

AUG 10 1967

August 7, 1967

COMPANY: DRUNSON-SPINES  
 CONTRACTOR: BLACKSTONE DRILLING, INC.  
 FARM: DARR #1, Zenith Unit Tract #20  
 LOCATION: 1320' East of West Line & 330' North of the South Line in the NW/4 of 6-24-10  
 COMMENCED: July 29, 1967  
 COMPLETED: August 5, 1967  
 ELEVATION:

0	to	135	Sand & Shale
135	to	250	Redbed and Lime
250	to	1400	Redbed and Shale
1400	to	2050	Lime & Shale
2050	to	2315	Shale & Lime
2315	to	2615	Shale & Shells
2615	to	2770	Lime
2770	to	2945	Shale & Lime
2945	to	3160	Lime
3160	to	3330	Sand & Shale
3330	to	3575	Lime
3575	to	3678	Lime & Shale
3678	to	3720	Shale
3720	to	3782	Hisner Shale
		3782	Lime
			T. D.

Cut 12 1/4 in. hole to 250 ft. and run 257 ft. of 8 5/8 in. surface pipe and cemented with 250 sacks on bottom at 250 ft. Plug down at 5:30 P.M., July 28, 1967. Cut 7 7/8 in. hole to 3782 ft., and run 3783.40 ft. of 5 1/2 in. casing, set on bottom at 3782 ft. Cemented with 100 sacks salt saturated Pozmix. Plug down at 3:45 P.M., August 5, 1967.

TCPs: Douglas - 3216' Brown Lime - 3285' Kansas City - 3302'  
 Kinderhook - 3663' Hisner Sand - 3696' Viola - 3706'

Measurements taken from K.B.

### CERTIFICATE

I, H. J. Plouffe, President of Blackstone Drilling, Inc. do hereby certify that the above and foregoing is a true and correct copy of log on your Darr #1, located on the Northwest Quarter of Sec. 6-24-10, Reno County, Kansas, 1320 ft. East of the West line, and 330 ft. North of the south line, as reflected by the files of BLACKSTONE DRILLING, INC.

  
 H. J. Plouffe, President

Subscribed and sworn to before me, a Notary Public in and for McPherson County, Kansas the 7<sup>th</sup> day of August, 1967.

  
 Ruth McVay - Notary Public

My Commission Expires: December 18, 1969.....