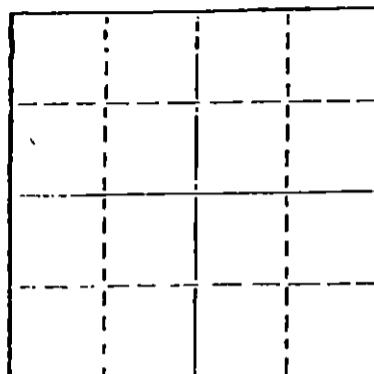


STATE OF KANSAS
STATE CORPORATION COMMISSION

Give All Information Completely
Make Required Affidavit
Mail or Deliver Report to
Conservation Division
State Corporation Comm.
245 North Water
Wichita, KS 67202

Locate well correctly on above
Section Plat

WELL PLUGGING RECORD

Stafford County. Sec. 24 Twp. 24S Rge. 11W ~~SW~~
Location as "NE/CNW~~1~~SW~~4~~" or footage from lines _____

SE SW NW

Lease Owner Eagle Exploration
Lease Name McComb Well No. 1

Office Address Star Route, Pratt, Ks 67124
Character of Well (Completed as Oil, Gas or Dry Hole) _____

Dry Hole

Date Well completed 4-18 1984
Application for plugging filed 4-17 1984

Application for plugging approved 4-17 1984
Plugging commenced 4-18 1984

Plugging completed 4-18 1984
Reason for abandonment of well or producing formation _____

Dry

If a producing well is abandoned, date of last production 19

Was permission obtained from the Conservation Division or
its agents before plugging was commenced? Yes

Name of Conservation Agent who supervised plugging of this well State Com @ Dodge City
Producing formation Depth to top Bottom Total Depth of Well 3833
Show depth and thickness of all water, oil and gas formations.

OIL, GAS OR WATER RECORDS

CASING RECORD

FORMATION	CONTENT	FROM	TO	SIZE	PUT IN	PULLED OUT
		0	286	8 5/8		

Describe in detail the manner in which the well was plugged, indicating where the mud fluid was placed and the method or methods used in introducing it into the hole. If cement or other plugs were used, state the character of same and depth placed, from _____ feet to _____ feet for each plug set. Plugged:

70 sacks @ 900

50 sacks @ 330

40 sacks bridge plug

10 sacks to cellar

15 sacks in rathole

10 sacks in mousehole

Cemented by Allied 4-18-84 Completed @ 8:45PM

(If additional description is necessary, use BACK of this sheet)

Name of Plugging Contractor DaMac Drilling Inc.

STATE OF Kansas COUNTY OF Barton, ss.
Martha J. McKown (employee of owner) or (owner or operator)
of the above-described well, being first duly sworn on oath, says: That I have knowledge of
the facts, statements, and matters herein contained and the log of the above-described well
as filed and that the same are true and correct. So help me God.

(Signature) Martha J. McKown
Box 1164, Great Bend, Ks 67530

(Address)

SUBSCRIBED AND SWORN TO before me this
STATE NOTARY PUBLIC
ELLSWORTH COUNTY, KANSAS
MY APPT. EXP. 3-19-86

19th day of April, 1984

Sheresa E. McKinney
Notary Public.

My commission expires 3-19-86

RECEIVED
STATE CORPORATION COMMISSION

MAY 07 1984

5-7-84

CONSERVATION DIVISION
Wichita, Kansas

WELL LOG

COMPANY Eagle Exploration

SEC. 24 T. 24S R. 11W

McComb

1

LOC. SE SW NW

TOTAL DEPTH 3833 RTD

COUNTY Stafford, Ks

DATE 4-12-84

CDMP. 4-18-84

CONTRACTOR DaMac Drilling Inc.

CAVING 8 5/8 set @ 286

EL ELEVATION

P&A

PRODUCTION

FIGURES INDICATE FEET OF FORMATIONS

Sand	0	132
Sand, RedBed	132	286
Sand, Shale	286	1620
Shale	1620	1960
Lime, Shale	1960	3833 RTD

RECEIVED
STATE CORPORATION COMMISSION

MAY 07 1984

State of Kansas }
County of Barton }

CONSERVATION DIVISION
Wichita, Kansas

I, Martha J. McKown of DaMac Drilling Inc.

do hereby state that the above and foregoing is a true and correct copy of the log of the McComb #1

Theresa E. McKinney
STATE NOTARY PUBLIC
ELSWORTH COUNTY, KANSAS
MY APPT. EXP. 3-19-86

Martha J. McKown

Subscribed and sworn to before me this 18th day of April 1984

My Commission Expires 3-19-86

Theresa McKinney