

STATE OF KANSAS
STATE CORPORATION COMMISSIONGive All Information Completely
Make Required Affidavit
Mail or Deliver Report to:Conservation Division
State Corporation Commission
800 Bittling Building
Wichita, Kansas


WELL PLUGGING RECORD

OR

FORMATION PLUGGING RECORD

Strike out upper line
when reporting plug-
ging off formations.

NORTH

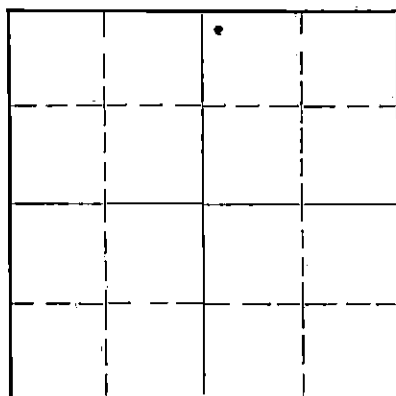Locate well correctly on above
Section Plat

Stafford County. Sec. 24. Twp. 24S. Rge. (E) 11 (W)
 Location as "NE $\frac{1}{4}$ NW $\frac{1}{4}$ SW $\frac{1}{4}$ " or footage from lines NW-NW-NE
 Lease Owner E. H. Moore Inc.
 Lease Name R. B. Wallace Well No. 1
 Office Address P. O. Box 1709, Tulsa, Oklahoma.
 Character of Well (Completed as Oil, Gas or Dry Hole) Dry hole
 Date, well completed 1-5-39 193
 Application for plugging filed 1-10-39 193
 Application for plugging approved 193
 Plugging Commenced 2-2-39 193
 Plugging Completed 2-6-39 193
 Reason for abandonment of well or producing formation Dry hole
 If a producing well is abandoned, date of last production -- 193
 Was permission obtained from the Conservation Division or its agents before plugging was commenced?
 Yes

Name of Conservation Agent who supervised plugging of this well Guy Wiershing
 Producing formation Misener Depth to top 3798 Bottom 3807 Total Depth of Well 3812 Feet.
 Show depth and thickness of all water, oil and gas formations.

OIL, GAS OR WATER RECORDS

CASING RECORD

Formation	Content	From	To	Size	Put In	Pulled Out
Started catching sample at 300' Topeka	Lime			10 3/4"	244	None
Topeka Lime	barren	3000	3200	7"	3,799	1806
Shale	"	3200	3385			
Lansing	"	3385	3720			
Kinderhook shale	"	3720	3798			
Misener	water	3798	3807			
Top viola	"	3807	3812			
Total depth 3812'.						

Describe in detail the manner in which the well was plugged, indicating where the mud fluid was placed and the method or methods used in introducing it into the hole. If cement or other plugs were used, state the character of same and depth placed, from feet to feet for each plug set.

Total depth 3812'.



Cement plug 3812' to 3784'.

Heavy mud 3784' to 280'.

15' of cement plug and rock below fresh water at 260'.

Heavy mud within 15' of top.

5 sacks of cement at top of pipe at base of cellar.

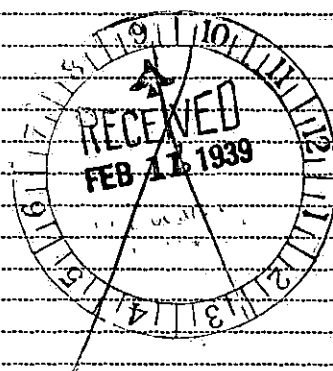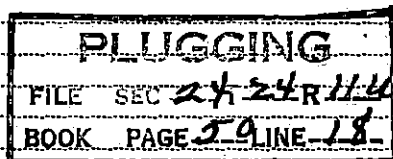

(If additional description is necessary, use BACK of this sheet)

Correspondence regarding this well should be addressed to E. H. Moore Inc.
 Address P. O. Box 1709, Tulsa, Oklahoma.

STATE OF OKLAHOMA, COUNTY OF Tulsa, ss.
 C. V. Wilcoxson, (employee of owner) or (owner or operator) of the above-described well,
 being first duly sworn on oath, says: That I have knowledge of the facts, statements, and matters herein contained and the log of the above-described well as filed and that the same are true and correct. So help me God.

(Signature)

C. V. Wilcoxson

Assistant Secretary

Box 1709, Tulsa, Oklahoma

(Address)

SUBSCRIBED AND SWORN to before me this 15th day of February, 1939

My commission expires December 9, 1939

17-3443

3-38-3M

Notary Public.

WELL RECORD

R. B. Wallace No. 1

Located - NW $\frac{1}{4}$ NW $\frac{1}{4}$ NE $\frac{1}{4}$, Section 24, T 24 S, Range
11 W, Stafford County, Kansas

Drilling Commenced - Dec. 18, 1938

Drilling Completed - Jan. 5, 1939.

Hisson & Wolfe Drilling Co. - Drilling Contractor.

Elevation of Well - 1785'

Sand and Clay	0	278
Red Bed	278	405
Shale & Shells	405	1628
Lime	1628	1825
Shale & Lime	1825	2187
Shale	2187	2698
Lime	2698	2730
Lime - Broken	2730	2802
Shale & Lime	2802	2925
Lime	2925	3250
Shale & Lime	3250	3385
Lime	3385	3555
Lime & Shale	3555	3578
Lime	3578	3741
Lime & Shale	3741	3795
Sand	3795	3805

Rotary Tools to 3805'

Cable Tools 3805' to 3812',

Total Depth.

Misener Sand 3798' (-2013)

Viola Lime 3809' (-2024)

Casing Record:

12-18-1938

240' - 10-3/4" casing, 250 sacks
cement.

1-1-1939

3805' - 7" casing, 165 sacks cement.

1-5-1939

Making 8 bailers water per hour.

Dry & Abandoned.

Feb. 6-1939

Salvaged 1806' - 7" casing and 1 -
10-3/4"x7" OWI Casinghead.

Plugged well.

