


STATE OF KANSAS  
STATE CORPORATION COMMISSION

Give All Information Completely  
Make Required Affidavit  
Mail or Deliver Report to:  
Conservation Division  
State Corporation Commission  
211 No. Broadway  
Wichita, Kansas

WELL PLUGGING RECORD

NORTH

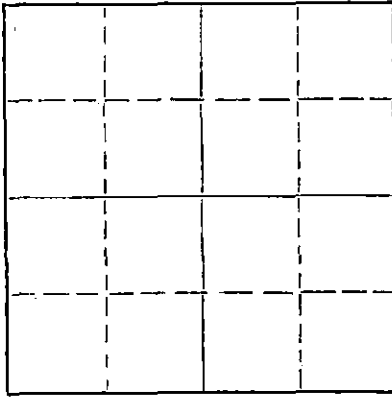

Locate well correctly on above  
Section Plat

Stafford County. Sec. 11 Twp. 24 Rge. (E) 12 (W)  
Location as "NE/CNW/SE/SW" or footage from lines CS/2-SE/4-NW/4  
Lease Owner Herman George Kaiser, Oil Producer  
Lease Name Hildebrand Well No. 3  
Office Address Ellinwood, Kansas  
Character of Well (completed as Oil, Gas or Dry Hole) \_\_\_\_\_  
Date well completed \_\_\_\_\_ 19\_\_\_\_  
Application for plugging filed \_\_\_\_\_ 19\_\_\_\_  
Application for plugging approved \_\_\_\_\_ 19\_\_\_\_  
Plugging commenced 4-28 1959  
Plugging completed 5-01 1959  
Reason for abandonment of well or producing formation \_\_\_\_\_

If a producing well is abandoned, date of last production \_\_\_\_\_ 19\_\_\_\_  
Was permission obtained from the Conservation Division or its agents before plugging was commenced? Yes

Name of Conservation Agent who supervised plugging of this well Frank Broadfoot  
Producing formation \_\_\_\_\_ Depth to top \_\_\_\_\_ Bottom \_\_\_\_\_ Total Depth of Well \_\_\_\_\_ Feet  
Show depth and thickness of all water, oil and gas formations.

OIL, GAS OR WATER RECORDS

CASING RECORD

FORMATION	CONTENT	FROM	TO	SIZE	PUT IN	PULLED OUT
				8 5/8	230	None
				5 1/2	3839	3086.91

Describe in detail the manner in which the well was plugged, indicating where the mud fluid was placed and the method or methods used in introducing it into the hole. If cement or other plugs were used, state the character of same and depth placed, from \_\_\_\_\_ feet to \_\_\_\_\_ feet for each plug set.

Sanded from 3840' to 3830' - dumped 5 sks cement -  
squeezed well with 20 sks Jell Mud and 80 sks of cement.

RECEIVED  
STATE CORPORATION COMMISSION  
MAY 14 1959  
CONSERVATION DIVISION  
Wichita, Kansas

(If additional description is necessary, use BACK of this sheet)

Name of Plugging Contractor R & D Casing Pulling Company License # 236  
Address Box 569 Ellinwood, Kansas

STATE OF Kansas, COUNTY OF Barton, ss.  
I, W. J. Hall (employee of owner) or (owner or operator) of the above-described well, being first duly sworn on oath, says: That I have knowledge of the facts, statements, and matters herein contained and the log of the above-described well as filed and that the same are true and correct. So help me God.

(Signature) W. J. Hall

(Address) \_\_\_\_\_

SUBSCRIBED AND SWORN TO before me this 7 day of May, 19 59

Delmer L. Posten

Notary Public.

My commission expires \_\_\_\_\_

PLUGGING  
FILE SEC. 11 T. 24 R. 12  
BOOK PAGE 39 LINE 7

LOG

Company: M. B. Armer  
 Contractor: Judy Drilling Company, Inc.  
 Drilling commenced: 4/24/50  
 Drilling completed: 5/10/50  
 Elevation 1865 D.F.  
 1862 Gr.  
 1867 R.E.

Farm: Hildebrand - well # 3  
 Location: C S $\frac{1}{2}$  SE NW $\frac{1}{4}$  11-24S-12W,  
 Stafford County, Kansas  
 Casing record: 8-5/8" @ 203' w/200 sacks  
 cement.  
 5 $\frac{1}{2}$ " @ 3839' corr. - 3944'  
 with 100 sacks

(figures below indicate bottoms)

Clay & sand	155
Red bed	640
Anhydrite	665
Shale & shells	1520
Sandy lime	1570
Lime	1835
Sandy lime	1900
Lime & shale	2320
Shale	2570
Shale & lime	2835
Broken lime	2905
Shale	2955
Lime & shale	3000
Lime	3130
Lime	3800
Shale & lime	3100
Shale	3110
Lime & shale	3500
Lime & shale	3555
Broken lime	3590
Lime & shale	3590
Lime & shale	3675
Lime	3720
Lime & shale	3785
Shale	3825
Shale & chert	3836
Cherty shale & lime	3840
Total Depth - rotary	3940 SLM corr - 3945'

**RECEIVED**  
 STATE CORPORATION COMMISSION  
 APR 21 1959  
 CONSERVATION DIVISION  
 Wichita, Kansas

FORMATION TOPS:

Heebner	3265
Brown lime	3420
Lansing Kansas City	3445
Viola	3839 corr; 3844

I hereby certify that this is a true and correct log of the above described well as shown by the drilling reports.

JUDY DRILLING COMPANY, INC.

By *L. P. Spinning*

STATE OF KANSAS )  
 ) ss:  
 COUNTY OF SEDGWICK )

Subscribed and sworn to before me, a notary public, in and for said County and State this 15 day of May, 1950.

*Hazel Walton*  
 Notary Public

My commission expires Sept. 17, 1951.

<b>PLUGGING</b>
FILE SEC. <u>11</u> T <u>24</u> R <u>12w</u>
BOOK PAGE <u>32</u> LINE <u>37</u>