


STATE OF KANSAS
STATE CORPORATION COMMISSION

WELL PLUGGING RECORD

Give All Information Completely
Make Required Affidavit
Mail or Deliver Report to:
Conservation Division
State Corporation Commission
800 Bitting Building
Wichita, Kansas

NORTH

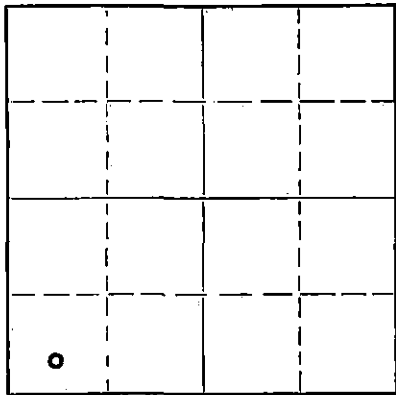

Locate well correctly on above
Section Plat

Stafford County, Sec. 11 Twp. 24 Rge. 12 (E) - W(W)

Location as "NE/CNW/SW" or footage from lines S/2, SW/4, SW/4

Lease Owner Stanolind Oil and Gas Company

Lease Name O'Connor-Schneider Unit No. 1 Well No. 1

Office Address P. O. Box 1654, Oklahoma City, Oklahoma

Character of Well (completed as Oil, Gas or Dry Hole) Oil

Date well completed 10-14 1941

Application for plugging filed 5-20 1952

Application for plugging approved 5-21 1952

Plugging commenced 5-28 1952

Plugging completed 6-5 1952

Reason for abandonment of well or producing formation depleted

If a producing well is abandoned, date of last production 4-16 1952

Was permission obtained from the Conservation Division or its agents before plugging was commenced? Yes

Name of Conservation Agent who supervised plugging of this well M. A. Rives

Producing formation Viola Depth to top 3824 Bottom 3832 Total Depth of Well 3832 Feet

Show depth and thickness of all water, oil and gas formations.

OIL, GAS OR WATER RECORDS

CASING RECORD

FORMATION	CONTENT	FROM	TO	SIZE	PUT IN	PULLED OUT
Viola	Oil-Depleted	3824	3832	8-5/8	273	None
				5-1/2	3845	1798

Describe in detail the manner in which the well was plugged, indicating where the mud fluid was placed and the method or methods used in introducing it into the hole. If cement or other plugs were used, state the character of same and depth placed, from _____ feet to _____ feet for each plug set.

Crushed Rock 3832 - 3815
 5 sx cement 3815 - 3780
 Hvy. mud 3780 - 211
 60 sx cement 211 - 6 bottom of cellar

(If additional description is necessary, use BACK of this sheet)

Name of Plugging Contractor Pipe Pulling, Inc.

Address Stafford, Kansas

STATE OF Kansas, COUNTY OF Barton, ss.

I, G. A. Younie (employee of owner) or (owner or operator) of the above-described well, being first duly sworn on oath, says: That I have knowledge of the facts, statements, and matters herein contained and the log of the above-described well as filed and that the same are true and correct. So help me God.

(Signature) *G. A. Younie*

P. O. Box 7, Ellinwood, Kansas (Address)

SUBSCRIBED AND SWORN TO before me this 11th day of June, 1952

Lewis B. Souwan
Notary Public.

My Commission expires May 2, 1955

PLUGGING
FILE SEC-117-24-1-1-1
BOOK PAGE-17-1-1-25

RECEIVED
STATE CORPORATION COMMISSION

JUN 14 1952
6-14-52
CONSERVATION DIVISION
Wichita, Kansas

FORMATION RECORD

DESCRIBE EACH FORMATION DRILLED. INDICATE THICKNESS, CONTENT AND WHETHER DRY, OR OIL, GAS, OR WATER BEARING.

FORMATION	TOP	BOTTOM	FORMATION	TOP	BOTTOM
Cellar	0	6			
Sand	6	120			
Red Bed	120	627			
Anhydrite	627	665			
Red bed and shale	665	833			
Shale and shells	833	1077			
Lime and sand	1077	1115			
Shale	1115	1339			
Shale and lime	1339	1660			
Lime and sand	1660	1725			
Lime and shale	1725	1863			
Shale	1863	1920			
Broken lime	1920	1967			
Lime and shale	1967	2025			
Lime, broken	2025	2055			
Lime	2055	2130			
Shale and lime	2130	2149			
Shale and shells	2149	2187			
Shale and lime	2187	2255			
Shale	2255	2296			
Shale and lime	2296	2400			
Shale	2400	2442			
Lime and shale	2442	2475			
Shale, lime and shells	2475	2558			
Shale	2558	2633			
Broken shale and lime	2633	2716			
Broken lime	2716	2762			
Lime and shale	2762	2865			
Broken lime and shale	2865	2960			
Lime	2960	3073			
Lime, hard	3073	3145			
Lime	3145	3269			
Broken lime	3269	3331			
Broken lime and shale	3331	3393			
Broken lime	3393	3430			
Lime	3430	3489			
Broken lime and shale	3489	3546			
Lime and chert	3546	3566			
Lime	3566	3742			
Lime and shale	3742	3784			
Black shale	3784	3824			
Lime	3824	3832			
TOTAL DEPTH		3832			

PLUGGING
 FILE SEC 11T 24R 14u
 BOOK PAGE 17 LINE 25