


STATE OF KANSAS
STATE CORPORATION COMMISSION

WELL PLUGGING RECORD

Give All Information Completely
Make Required Affidavit
Mail or Deliver Report to
Conservation Division
State Corporation Comm.
245 North Water
Wichita, KS 67202

Stafford County, Sec. 14 Twp. 24 Rge. 12 EXW
Location as "NE/CNW $\frac{1}{4}$ SW $\frac{1}{4}$ " or footage from lines 660 from
South line 330 from west line
Lease Owner Schmidts oil co.
Lease Name O'Connor Kirkpatrick Well No. 1
Office Address Tribune Kansas
Character of Well (Completed as Oil, Gas or Dry Hole) oil

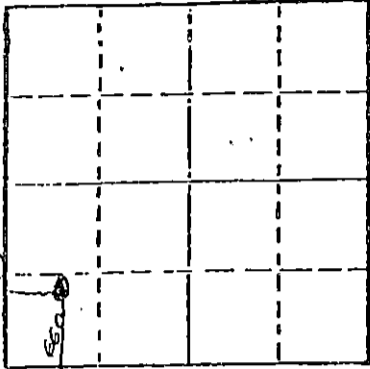

Locate well correctly on above
Section Plot

Date Well completed _____ 19____
Application for plugging filed _____ 1984
Application for plugging approved July 1984
Plugging commenced July 29 1984
Plugging completed July 30 1984
Reason for abandonment of well or producing formation dry

If a producing well is abandoned, date of last production _____ 1978

Was permission obtained from the Conservation Division or its agents before plugging was commenced? Yes

Name of Conservation Agent who supervised plugging of this well Wm J Metz
Producing formation Viola Depth to top _____ Bottom _____ Total Depth of Well 3850
Show depth and thickness of all water, oil and gas formations.

OIL, GAS OR WATER RECORDS

CASING RECORD

FORMATION	CONTENT	FROM	TO	SIZE	PUT IN	PULLED OUT
<u>No Records on</u>	<u>Well</u>			<u>6 5/8 Casing</u>		<u>None</u>
				<u>10 1/2 Surface</u>		

Describe in detail the manner in which the well was plugged, indicating where the mud fluid was placed and the method or methods used in introducing it into the hold. If cement or other plugs were used, state the character of same and depth placed, from 3000 feet to 3850 feet for each plug set. run in 2 1/2 tubing, pumped cement down tubing to plug bottom, pumped in 140 sacks on the 29th July 84, pulled tubing up the 600 feet, pumped another 140 sacks cement 600 pound pressure, circulated cement to surface, pulled all 2 1/2 tubing, run in 300 foot Lynch tubing between surface and casing, pumped in 10 sacks cement circulating to surface, pulled 1 1/2 tubing, left well set 3 days, cement settled, put in 1 yard road mix to fill surface and casing, cut casing and surface off 8 feet below ground level.

(If additional description is necessary, use BACK of this sheet)

Name of Plugging Contractor Halliburton

STATE OF Kansas COUNTY OF Stafford, ss.
Herald Fischer (employee of owner) or (owner or operator)
of the above-described well, being first duly sworn on oath, says: That I have knowledge of the facts, statements, and matters herein contained and the log of the above-described well as filed and that the same are true and correct. So help me God.

(Signature) Herald Fischer
R.R. 1 Clewley Home 67577
(Address)

SUBSCRIBED AND SWORN TO before me this 5th day of September, 19 84.

Wanda F. Volker
Notary Public.

My commission expires 11-2-85

RECEIVED
STATE CORPORATION COMMISSION

9-6-84
SEP 06 1984

WANDA F. VOLKER
NOTARY PUBLIC
State of Kansas
My Appointment Expires 11-2-85