

STATE OF KANSAS
STATE CORPORATION COMMISSION


Give All Information Completely
Make Required Affidavit
Mail or Deliver Report to:
Conservation Division
State Corporation Commission
211 No. Broadway
Wichita, Kansas

WELL PLUGGING RECORD

Reno County, Sec. 24 Twp. 23S Rge. 5 (Ex) (W)

Location as "NE/CNWxSWx" or footage from lines C SE SE SW
Lease Owner Helmerich & Payne, Inc.
Lease Name STRANDBERG Well No. 1
Office Address P.O. Box 558, Garden City, Kansas
Character of Well (completed as Oil, Gas or Dry Hole) Dry Hole
Date well completed 9-12-64 19 64
Application for plugging filed 9-17- 19 64
Application for plugging approved 9-12- 19 64
Plugging commenced 9-12- 19 64
Plugging completed 9-12- 19 64
Reason for abandonment of well or producing formation - (Drilled Dry)

NORTH

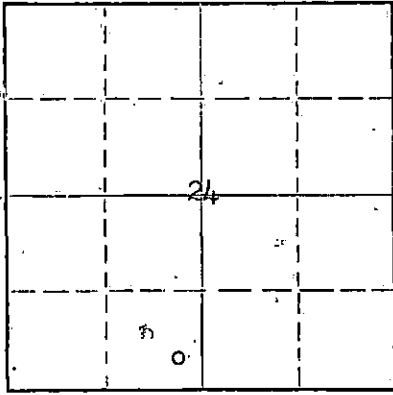

Locate well correctly on above Section Plat

If a producing well is abandoned, date of last production - 19 -
Was permission obtained from the Conservation Division or its agents before plugging was commenced? Yes

Name of Conservation Agent who supervised plugging of this well Mr. Gilbert J. Toman
Producing formation none Depth to top - Bottom - Total Depth of Well 3906 Feet
Show depth and thickness of all water, oil and gas formations.

OIL, GAS OR WATER RECORDS

CASING RECORD

FORMATION	CONTENT	FROM	TO	SIZE	PUT IN	PULLED OUT
none				8-5/8"	740	0

Describe in detail the manner in which the well was plugged, indicating where the mud fluid was placed and the method or methods used in introducing it into the hole. If cement or other plugs were used, state the character of same and depth placed, from feet to feet for each plug set.

Plugged thru drill pipe in following manner:

- 3906-730: Heavy drilling mud
- 730-670: Wiper plug plus 1/4 sack hulls to bridge plus 20 sacks of cement
- 670-240: Heavy drilling mud
- 240-180: Wiper plug plus 1/4 sack hulls to bridge plus 20 sacks of cement
- 180-40 : Heavy drilling mud.
- 40-0 : Wiper plug plus one sack of hulls to bridge plus 10 sacks of cement.

RECEIVED
STATE CORPORATION COMMISSION

SEP 18 1964
9-18-64
CONSERVATION DIVISION
Wichita, Kansas

Name of Plugging Contractor Globe Cementing (Thru drill pipe.)
Address Great Bend, Kansas

STATE OF Kansas, COUNTY OF Finney, ss.
C. A. Richter (employee of owner) of the above-described well, being first duly sworn on oath, says: That I have knowledge of the facts, statements, and matters herein contained and the log of the above-described well as filed and that the same are true and correct. So help me God.

(Signature) C. A. Richter

P.O. Box 558, Garden City, Kansas (Address)

SUBSCRIBED AND SWORN to before me this 17th day of September, 1964

My commission expires July 1, 1968

Robert N. Boyd Notary Public.

DRILLER'S LOG

Well Owner: Helmerich & Payne, Inc.
 Well Name: G. E. Strandberg No. 1
 Date Started: 9-1-64
 Date Completed: 9-12-64
 Total Depth: 3904

C SE Se SW
 Sec 24-23S-5W
 Reno County, Kansas

Casing: 8-5/8" set at 740' cemented

Contractor: Peel Brothers, Inc.

Figures below indicate bottoms of formations:

Sand	0 -	95
Shale		130
Shale - Blue Shells		370
Shale and Salt		615
Anhydrite		739
Shale and Lime		3358
Lime and Chert		3404
Mississippi Chert & Lime		3465
Mississippi Lime		3530
Chert & Lime		3575
Mississippi		3591
Kind Shale		3595
Lime		3869
Lime and Shale		3904
Total Depth		3904

This is to certify that the above information is to the best of our knowledge true and correct.

PEEL BROTHERS, INC.

Jack Mattocks
 W. E. "Jack" Mattocks
 Drilling Superintendent

SUBSCRIBED AND SWORN to before me this 15th day of September, 1964

Ethel S. Williamson
 Notary Public

RECEIVED
 STATE CORPORATION COMMISSION

SEP 22 1964

CONSERVATION DIVISION
 Wichita, Kansas.