


WELL PLUGGING RECORD

Give All Information Completely  
Make Required Affidavit  
Mail or Deliver Report to:  
Conservation Division  
State Corporation Commission  
212 North Market, Insurance Bldg.  
Wichita, Kansas

Reno County, Sec. 28 Twp. 23 S Rge. (E) 5 (W)  
Location as "NE/CNW/SW" or footage from lines SE/4 SE/4 SE/4  
Lease Owner Messman-Rinehart Oil Company  
Lease Name Eskel Swanson Well No. 1  
Office Address 518 Petroleum Building, Wichita, Kansas  
Character of Well (completed as Oil, Gas or Dry Hole) Dry Hole  
Date well completed October 30 1959  
Application for plugging filed November 10 1959  
Application for plugging approved November 12 1959  
Plugging commenced November 14 1959  
Plugging completed November 19 1959  
Reason for abandonment of well or producing formation Dry

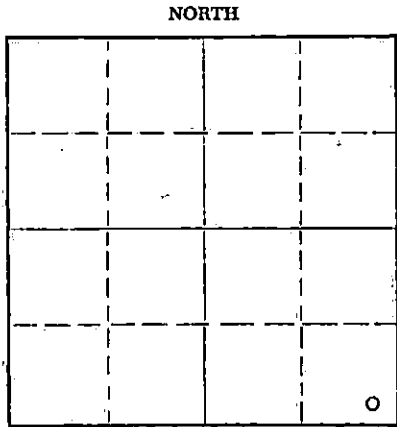

Locate well correctly on above Section Plat

If a producing well is abandoned, date of last production 19  
Was permission obtained from the Conservation Division or its agents before plugging was commenced? yes

Name of Conservation Agent who supervised plugging of this well Fred W. Hampel, Pretty Prairie, Kansas  
Producing formation \_\_\_\_\_ Depth to top \_\_\_\_\_ Bottom \_\_\_\_\_ Total Depth of Well 3863 Feet  
Show depth and thickness of all water, oil and gas formations.

OIL, GAS OR WATER RECORDS

CASING RECORD

FORMATION	CONTENT	FROM	TO	SIZE	PUT IN	PULLED OUT
				10-3/4"	198'	none
				4-1/2"	3863'	3188'

Describe in detail the manner in which the well was plugged, indicating where the mud fluid was placed and the method or methods used in introducing it into the hole. If cement or other plugs were used, state the character of same and depth placed, from \_\_\_\_\_ feet to \_\_\_\_\_ feet for each plug set.

Sand to 3830 ft. Mixed and run 5 sx. cement at 3830' with dump bailer. Mud to 190 ft. Set 10 ft. rock bridge with 25 sx. cement. Mud to 35 ft. Set rock bridge at 35 ft. with 10 sx. cement to base of cellar.

STATE CORPORATION COMMISSION  
FEB 11 1960  
5-11-60  
CONSERVATION DIVISION  
Wichita, Kansas

(If additional description is necessary, use BACK of this sheet)  
Name of Plugging Contractor Southwest Casing Pulling Co., Inc. - License No. 399  
Address P. O. Box 364, Great Bend, Kansas

STATE OF Kansas COUNTY OF Sedgwick ss.  
J. A. Gilliland (employee of owner) or (owner/operator) of the above-described well, being first duly sworn on oath, says: That I have knowledge of the facts, statements, and matters herein contained and the log of the above-described well as filed and that the same are true and correct. So help me God.

(Signature) *J. A. Gilliland*  
518 Petroleum Bldg., Wichita, Kansas (Address)

SUBSCRIBED AND SWORN TO before me this 9th day of February 1960  
*Barbara J. Scott*  
Barbara J. Scott, Notary Public.

My commission expires December 1, 1960

*R*

15-155-02011-0000

NO. 1 ESKEL SWANSON

Well Record:

Location: SE/4 SE/4 SE/4  
Section 28-23S-5W  
Reno County, Kansas

Operator: Messman-Rinehart Oil Company  
518 Petroleum Building  
Wichita, Kansas

Contractor: Messman-Rinehart Oil Company  
518 Petroleum Building  
Wichita, Kansas

Casing Record: 10-3/4" @ 198' w/200 sk. con.  
4-1/2" @ 3863' w/100 sk. con.

Commenced: October 10, 1959  
Completed: October 25, 1959  
(rotary)  
Elevation: 1513' K/B  
Production: D & A

STATE OF KANSAS  
FEB 1 1960  
CONSERVATION DIVISION  
Wichita, Kansas

\*\*\* L O G \*\*\*

Sand	90
Shale & Red Bed	165
Shale	198
Shale & Shells	250
Shale, Shells & Salt	700
Lime & Shale	990
Anhydrite	1020
Lime & Shale	1720
Shale & Lime streaks	1950
Lime & Shale	2815
Lime	3185
Lime & Shale	3345
Lime & Shale & Chert	3400
Lime & Chert	3505
Chert & Lime	3555
Lime, Shale & Chert	3585
Lime & Shale	3635
Shale	3733
Lime	3737
Lime & Shale	3785
Shale	3818
Lime	3851
Sand	3863 R.T.D.

Sample Tops:

2492' - Heebner (-979)  
2693' - Brown Lime (-1180)  
2726' - Lansing (-1213)  
3396' - Mississippian (-1883)  
3610' - Kinderhook (-2097)  
3733' - Hunton (-2220)  
3762' - Maquoketa (-2249)  
3831' - Viola (-2318)  
3851' - Simpson (-2338)

The undersigned, MESSMAN-RINEHART OIL COMPANY, hereby certifies that the above log is a true and correct log of the formation encountered in drilling the above well as reflected by the Daily Drilling Reports.

MESSMAN-RINEHART OIL COMPANY  
By: J. A. Gilliland  
J. A. Gilliland

Subscribed and sworn to before me this 9th day of November, 1959.

Barbara J. Scott  
Barbara J. Scott, Notary Public

My Commission Expires: December 1, 1960.

15-155-02 011-0000

COMPLETION DATA

Messman-Rinehart Oil Company  
No. 1 Eskel Swanson  
SE/4 SE/4 SE/4, Sec. 28-23S-5W  
Reno County, Kansas

- 10-27-59 - Moved in cable tools
- 10-28-59 - Perforated 3852-55' w/4<sup>5</sup> ft. - set overnight and made 8 gal. wtr. and show oil
- 10-29-59 - Double-perforated 3852-55' w/4<sup>5</sup> ft., treated with 250 gal. mud acid, Broke at 1750# and went in at 250#, went on vacuum in 3 minutes, Swabbed 10 BWPB w/scum of oil on 4-hr. swab test  
Dry and Abandoned - 10-29-59

MESSMAN-RINEHART OIL COMPANY

By: Roger L. Messman  
Roger L. Messman

RLH/bjs

RECEIVED  
STATE COMMISSION  
FEB 11 1960  
CONSERVATION DIVISION  
Wichita, Kansas