

15-145-20685-00-00

FORM CP-4


STATE OF KANSAS
STATE CORPORATION COMMISSION

WELL PLUGGING RECORD

Give All Information Completely
Make Required Affidavit
Mail or Deliver Report to
Conservation Division
State Corporation Comm.
245 North Water
Wichita, KS 67202

Pawnee County, Sec. 33 Twp. 21S Rge. 15W E/W
Location as "NE/CNW $\frac{1}{4}$ SW $\frac{1}{4}$ " or footage from lines
C N/2

Lease Owner Tenneco Oil Co.
Lease Name Harris Well No. 1-33
Office Address Ciudad Bldg; Ste. 139, 3000 United Founders
Character of Well (Completed as Oil, Gas or Dry Hole) Dry Hole

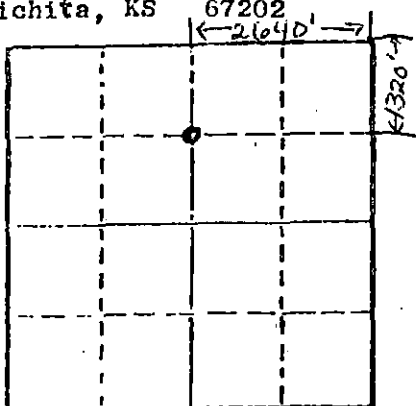

Locate well correctly on above
Section Plot

Date Well completed June 10 1980
Application for plugging filed (Verbally) June 10 1980
Application for plugging approved (Verbally) June 10 1980
Plugging commenced June 10 1980
Plugging completed June 10 1980
Reason for abandonment of well or producing formation
No commercial quantity of oil or gas encountered
If a producing well is abandoned, date of last production
19

Was permission obtained from the Conservation Division or
its agents before plugging was commenced? Yes

Name of Conservation Agent who supervised plugging of this well
Producing formation _____ Depth to top _____ Bottom _____ Total Depth of Well _____
Show depth and thickness of all water, oil and gas formations.

OIL, GAS OR WATER RECORDS

CASING RECORD

FORMATION	CONTENT	FROM	TO	SIZE	PUT IN	PULLED OUT

Describe in detail the manner in which the well was plugged, indicating where the mud fluid was placed and the method or methods used in introducing it into the hold. If cement or other plugs were used, state the character of same and depth placed, from _____ feet to _____ feet for each plug set.

T.D. 4006'

Set 1st plug at 960' with 60 sx. of 50/50 posmix, 4% gel

Mud to 420' - 30 sx.

Mud to 40' - 1/2 sx. hulls & wood plug

10 sx. to surface

3 sx. in rathole, 2 sx. in water well

Plug was down at 9:30 p.m. 6-10-80

Allied Cement

JUN 17 1980
6-17-80

(If additional description is necessary, use BACK of this sheet)

Name of Plugging Contractor KAW Drilling Co., Inc.

STATE OF Kansas COUNTY OF Sedgwick, ss.
K.S. Martin, President (employee of owner) or (owner or operator)
of the above-described well, being first duly sworn on oath, says: That I have knowledge of the facts, statements, and matters herein contained and the log of the above-described well as filed and that the same are true and correct. So help me God.

(Signature) K.S. Martin
1010 Union Center, Wichita, Kansas 67202
(Address)

SUBSCRIBED AND SWORN TO before me this 13th day of June, 1980

KATHY S. GOERTZ
Sedgwick County, Ks.
My Appt. Exp. 10/05/80

Kathy S. Goertz
Kathy S. Goertz Notary Public.

My commission expires _____

CONTRACTOR'S WELL LOG

15-145-20685-00-00

OPERATOR: Tenneco Oil Co.
 CONTRACTOR: KAW Drilling Co., Inc.
 WELL NAME: HARRIS #1-33
 LOCATION: C N/2, Section 33-21S-15W
 Pawnee County, Kansas
 SPUD DATE: May 31, 1980
 COMPLETION DATE: June 10, 1980

0	440	Sand & Shale
440	600	Sand
600	947	Red Bed
947	965	Anhydrite
965	1493	Red Bed & Shale
1493	1876	Shale
1876	2280	Shale & Lime
2280	2532	Shale
2532	3059	Shale w/Lime
3059	3480	Lime w/Shale
3480	3710	Shale w/Lime
3710	4006	Lime
	4006	R.T.D.

Spud hole at 4:20 p.m. 5-31-80. Ran 22 jts. of new 8 5/8" surface casing (Talley 950.01') Set at 963' K.B. with 300 sx. of 35/65 posmix, 6% gel, 3% Ca.Cl. followed with 200 sx. of Class "H", 3% Ca.Cl. Plug was down at 9:45 a.m. 6-01-80. Cement by Dowell.

T.D. 4006', Set 1st plug at 960' with 60 sx. of 50/50 posmix, 4% gel, mud to 420' - 30 sx., mud to 40' - 1/2 sx. hulls & wood plug, 10 sx. to surface, 3 sx. in rathole, 2 sx. in water well. Plug was down at 9:30 p.m. 6-10-80. Allied Cement.

STATE OF KANSAS)
) SS
 COUNTY OF SEDGWICK)

RECEIVED
 6-17-80
 JUN 17 1980
 COMMISSION
 DIVISION
 State, Kansas

K.S. Martin, President of KAW Drilling Co., Inc. does hereby state that the above and foregoing is a true and correct copy of the log of the Harris #1-33, C N/2, Section 33-21S-15W, Pawnee County, Kansas

KAW Drilling Co., Inc.

BY: K.S. Martin
 K.S. Martin, President

Subscribed and sworn to before me, a Notary Public, in and for the state and county aforesaid, as of this 13th day of June, 1980.



Kathy S. Goertz
 Kathy S. Goertz, Notary Public