


STATE OF KANSAS
STATE CORPORATION COMMISSION

Give All Information Completely
Make Required Affidavit
Mail or Deliver Report to:
Conservation Division
State Corporation Commission
P. O. Box 17027
Wichita, Kansas 67217
NORTH

WELL PLUGGING RECORD

Pratt County. Sec. 31 Twp. 29S Rge. (E) 14 (W)
Location as "NE/CNW/SW" or footage from lines SW SE 200' S of C
Lease Owner Allison Oil Company
Lease Name Howell Well No. 1
Office Address 507 Insurance Building, Wichita, Kansas 67202
Character of Well (completed as Oil, Gas or Dry Hole) Dry Hole
Date well completed December 4, 1973
Application for plugging filed December 4, 1973
Application for plugging approved December 4, 1973
Plugging commenced December 4, 1973
Plugging completed December 4, 1973
Reason for abandonment of well or producing formation Dry Hole

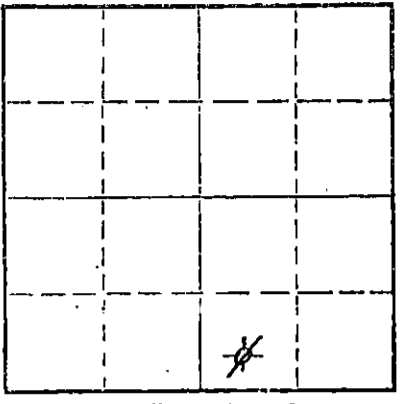

Locate well correctly on above Section Plat

If a producing well is abandoned, date of last production None 19
Was permission obtained from the Conservation Division or its agents before plugging was commenced? Yes

Name of Conservation Agent who supervised plugging of this well Russel Beaverstein
Producing formation _____ Depth to top _____ Bottom _____ Total Depth of Well _____ Feet
Show depth and thickness of all water, oil and gas formations.

OIL, GAS OR WATER RECORDS

CASING RECORD

FORMATION	CONTENT	FROM	TO	SIZE	PUT IN	PULLED OUT

Describe in detail the manner in which the well was plugged, indicating where the mud fluid was placed and the method or methods used in introducing it into the hole. If cement or other plugs were used, state the character of same and depth placed, from _____ feet to _____ feet for each plug set.

Filled hole with heavy drilling mud
Pushed plug to 250'
250 sacks cement
Mud to 40'
Plug @ 40'
15 sacks cement 40' to the surface
2 sacks cement in the rat hold
Cemented by Allied Cement Company

RECEIVED
STATE CORPORATION COMMISSION
DEC 26 1973
12-26-73
CONSERVATION DIVISION
Wichita, Kansas

(If additional description is necessary, use BACK of this sheet)
Name of Plugging Contractor DaMac Drilling Company, Inc
Address Box 1164, Great Bend, Kansas 67530

STATE OF KANSAS, COUNTY OF Barton, ss.
_____, (employee of owner) or (owner or operator) of the above-described well, being first duly sworn on oath, says: That I have knowledge of the facts, statements, and matters herein contained and the log of the above-described well as filed and that the same are true and correct. So help me God.

(Signature) Martha McKown
Box 1164, Great Bend, Kansas 67530
(Address)

SUBSCRIBED AND SWORN TO before me this 4th day of December, 1973

My commission expires September 13, 1977
Charlene M. Marker Notary Public.

CHARLENE M. MARKER
NOTARY PUBLIC
Barton County, Kansas
My Commission Expires
September 13, 1977

WELL LOG

COMPANY Charles Seaney

SEC. 31 T. 29S R. 14W

FARM Howell NO. 1

LOC. 200' S of C 3W SE

TOTAL DEPTH 891'

COUNTY Pratt, Kansas

COMM. 12-1-73 COMP. 12-4-73

CONTRACTOR Dakac Drilling Company, Inc.

CASING

ELEVATION

PRODUCTION P & A

FIGURES INDICATE BOTTOM OF FORMATIONS

66' Surface Clay
 130' Sand
 350' Red Bed
 568' Red Bed & Shale
 891' Red Bed
 Skidded Rig 160' South

RECEIVED
 STATE CORPORATION COMMISSION
 DEC 26 1973
 CONSERVATION DIVISION
 Wichita, Kansas

State of Kansas }
 County of Barton } SS

I, Martha J. McKown of Dakac Drilling Company, Inc.

upon oath state the above and foregoing is a true and correct copy of the log of the Howell No. 1 well.

CHARLENE M. MARKER
 NOTARY PUBLIC
 Barton County, Kansas
 My Commission Expires
 September 13, 1977

Martha J. McKown

12th day of December 19 73

My Commission Expires: September 13, 1977

Charlene M. Marker
 NOTARY PUBLIC