


Give All Information Completely  
Make Required Affidavit  
Mail or Deliver Report to:  
Conservation Division  
State Corporation Commission  
211 No. Broadway  
Wichita, Kansas

WELL PLUGGING RECORD

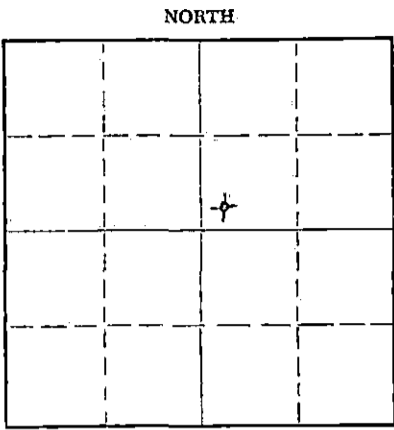

Locate well correctly on above  
Section Plat

Pratt County, Sec. 31 Twp. 29S Rge. (E) 14 (W)  
Location as "NE/CNW/SW" or footage from lines Ctr. SW SW NE  
Lease Owner Graybol Oil Corporation  
Lease Name Howell "B"  
Office Address 2200 N.B.T. Bldg., Tulsa, Okla. 74103  
Character of Well (completed as Oil, Gas or Dry Hole) Dry hole  
Date well completed May 19 1965  
Application for plugging filed May 19 1965  
Application for plugging approved May 19 1965  
Plugging commenced May 20 1965  
Plugging completed May 20 1965  
Reason for abandonment of well or producing formation

If a producing well is abandoned, date of last production 19  
Was permission obtained from the Conservation Division or its agents before plugging was commenced? Yes

Name of Conservation Agent who supervised plugging of this well Archie Elving  
Producing formation None Depth to top Bottom Total Depth of Well 4620 Feet  
Show depth and thickness of all water, oil and gas formations.

OIL, GAS OR WATER RECORDS

CASING RECORD

FORMATION	CONTENT	FROM	TO	SIZE	PUT IN	PULLED OUT
Lansing lime	Impermeable	4067	4459	8 5/8"	323'	None
Cherokee sand	salt water	4548	4554			
Cherokee chert	salt water	4564	4579			
Viola lime	salt water	4592	4620			

Describe in detail the manner in which the well was plugged, indicating where the mud fluid was placed and the method or methods used in introducing it into the hole. If cement or other plugs were used, state the character of same and depth placed, from feet to feet for each plug set.

Filled hole with heavy mud-laden fluid to 300'. Inserted plug. Placed in 1/2 sack of hulls. Cemented with 25 sacks of Portland cement. Filled hole with heavy mud-laden fluid to 40'. Inserted plug and 1/2 sack of hulls. Cemented with ten sacks of Portland cement. Placed two sacks of Portland cement in rat-hole.

RECEIVED  
STATE CORPORATION COMMISSION

5-24-65  
MAY 24 1965

CONSERVATION DIVISION  
Wichita, Kansas

(If additional description is necessary, use BACK of this sheet)

Name of Plugging Contractor None used.  
Address

STATE OF OKLAHOMA, COUNTY OF TULSA, ss.  
Lyman G. Dennis (employee of owner) or (owner or operator) of the above-described well, being first duly sworn on oath, says: That I have knowledge of the facts, statements, and matters herein contained and the log of the above-described well as filed and that the same are true and correct. So help me God.

(Signature) Lyman G. Dennis  
Tulsa, Oklahoma (Address)

SUBSCRIBED AND SWORN TO before me this 21st day of May, 1965

My commission expires October 2, 1967

Notary Public

GRAYBOL OIL CORPORATION

Pratt County, Kansas

No. 1 Howell "B"

Ctr. SW SW NE Sec. 31-29S-14W

Contractor: Company Tools

Elev. 2009 D.F., 2003 G.L.

Commenced: May 4, 1965

Completed: May 19, 1965

Production: Dry and Abandoned

CASING RECORD

Set 8 5/8" casing @ 323' with 225 sacks of pozmix cement.

DEPTH	FORMATION	WELEX ELECTRIC LOG TOPS:	
0-50	Surface clay	Stone Corral anhydrite	863 (+1146)
50-200	Sand	Heebner shale	3869 (-1860)
200-615	Red bed and shale	Brown lime	4055 (-2046)
615-810	Shale and shells	Lansing lime	4067 (-2058)
810-820	Anhydrite	Base of Kansas City	4459 (-2450)
820-855	Red bed	Marmaton	4472 (-2463)
855-862	Anhydrite	Cherokee formation	4544 (-2535)
862-1015	Shale and shells	Cherokee sand	4548 (-2539)
1015-1570	Lime shells	Cherokee chert	4564 (-2555)
1570-2010	Shale and shells	Viola	4592 (-2583)
2010-2135	Shale and lime		
2135-2520	Lime and shale	Drill Stem Test No. 1 - 4545-4558:	
2520-2715	Shale and lime	Tool open 1 1/2 hours. Recovered 10'	
2715-4160	Lime and shale	oil and gas-cut muddy water, 300'	
4160-4558	Lime	clear salt water. IBHP 720#/30"	
4558-4580	Chert	FBHP 564#/30", IFP-31#, FFP 156#,	
4580-4608	Lime and chert	BHT-118°F.	
4608-4620	Cherty lime	Drill Stem Test No. 2 - 4563-4580:	
4620	Total Depth	Tool open 30 mins. Recovered 1330' salt	
		water. No show of oil or gas. IBHP 1148#/30",	
		FBHP 730#/30", IFP 271#, FFP-678#.	
		BHT 120°F.	

I hereby certify that the above is a true and correct log of the above-captioned well as taken directly from the daily drilling reports.

GRAYBOL OIL CORPORATION

BY: Lyman C. Dennis  
Lyman C. Dennis, Geologist

STATE OF OKLAHOMA

COUNTY OF TULSA

Subscribed and sworn to this 21st day of May, 1965.

My Commission expires: October 2, 1967

James B. Elder  
NOTARY PUBLIC

RECEIVED  
STATE CORPORATION COMMISSION

MAY 24 1965

CONSERVATION DIVISION  
Wichita, Kansas