

CARD MUST BE TYPED

State of Kansas  
**NOTICE OF INTENTION TO DRILL**

CARD MUST BE SIGNED

(see rules on reverse side)

151-21, 473-00-00

Starting Date: 9 2 84  
month day year

API Number 15-

OPERATOR: License # 5313 100' W of C W/2 SE  
Name F & M OIL CO., INC.  
Address 422 Union Center  
City/State/Zip Wichita, Kansas 67202  
Contact Person Debra FitzGerald  
Phone (316)262-2636

Sec 11 Twp 26S, Rge 13W  East  West  
(location)

1320' Ft North from Southeast Corner of Section  
2080' Ft West from Southeast Corner of Section  
(Note: Locate well on Section Plat on reverse side)

CONTRACTOR: License # 5103  
Name Union Drilling Co., INC.  
City/State Wichita, Kansas 67202

Nearest lease or unit boundary line 1320' feet.  
County Pratt  
Lease Name Keller "F" (G) Well# 6

Domestic well within 330 feet:  yes  no  
Municipal well within one mile:  yes  no

Well Drilled For: Well Class: Type Equipment:  
 Oil  Swd  Infield  Mud Rotary  
 Gas  Inj  Pool Ext.  Air Rotary  
 OWWO  Expl  Wildcat  Cable

Depth to Bottom of fresh water 150 feet  
Lowest usable water formation Top Permian  
Depth to Bottom of usable water 300 feet

If OWWO: old well info as follows:

Operator N/A  
Well Name  
Comp Date Old Total Depth

Surface pipe by Alternate: 1  2   
Surface pipe to be set 300 feet  
Conductor pipe if any required

Projected Total Depth 4400' feet  
Projected Formation at TD Arbuckle  
Expected Producing Formations Lansing

Ground surface elevation feet MSL  
This Authorization Expires 7-28-85  
Approved By [Signature]

I certify that we will comply with K.S.A. 55-101, et seq., plus eventually plugging hole to K.C.C. specifications.

Date 8-28-84 Signature of Operator or Agent

[Signature: Debra FitzGerald] Petroleum Geologist  
MHC/KOPE 8/28/84  
Form C-1 4/84

Must be filed with the K.C.C. five (5) days prior to commencing well  
 This card void if drilling not started within six (6) months of date received by K.C.C.


RECEIVED  
 STATE CORPORATION COMMISSION  
 8-28-84  
 AUG 28 1984

CONSERVATION DIVISION  
 WICHITA, KANSAS

**Important procedures to follow**

1. Notify District office before setting surface casing.
2. Set surface casing by circulating cement to the top.
3. File completion forms ACO-1 with K.C.C. within 90 days of well completion, following instructions on ACO-1, side 1, and including copies of wireline logs.
4. Notify District office 48 hours prior to old well workover or re-entry.
5. Prior to plugging, prepare a plugging plan, then obtain agreement from the appropriate district office for an approved plugging plan.
6. Submit plugging report (CP-4) to K.C.C. after plugging is completed.
7. Obtain an approved injection docket number before disposing of salt water.
8. Notify K.C.C. within 10 days when injection commences or terminates.
9. If an alternate 2 completion, cement in the production pipe from below any usable water to surface within 120 days of spud date.

**A Regular Section of Land  
 1 Mile = 5,280 Ft.**

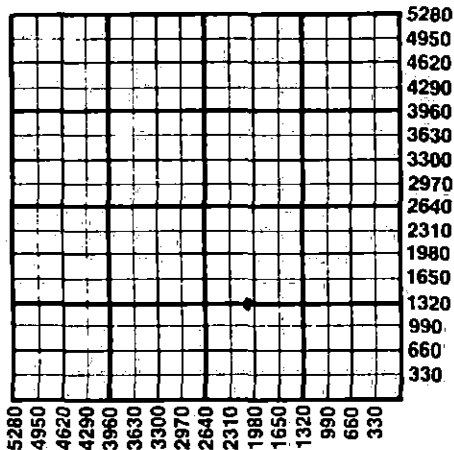

State Corporation Commission of Kansas  
 Conservation Division  
 200 Colorado Derby Building  
 Wichita, Kansas 67202  
 (316) 263-3238