

CARD MUST BE TYPED

State of Kansas

CARD MUST BE SIGNED

NOTICE OF INTENTION TO DRILL

(see rules on reverse side)

CORRECTION

2-20-86

Starting Date Feb 20 1986
month day yearAPI Number 15-151-21, 772-~~00~~-00OPERATOR: License # 8709
Name White Oilfield Supply Inc.
Address 914 W. 3rd
City/State/Zip Pratt, Kansas 67124
Contact Person Russell White
Phone 316672-7130CONTRACTOR: License # 5929
Name Duke Drilling Co. Inc.
City/State 620 Hubbard, Great Bend, KS 67530Well Drilled For: Well Class: Type Equipment:
 Oil SWD Infield Mud Rotary
 Gas Inj Pool Ext. Air Rotary
 OWWO Expl Wildcat Cable

If OWWO: old well info as follows:

Operator
Well Name
Comp Date Old Total Depth

I certify that well will comply with K.S.A. 55-101, et seq., plus eventually plugging hole to KCC specifications.

Date .. 2/20/86 Signature of Operator or Agent *Sherril Sholar* Title... as agent.....

For KCC Use:

Conductor Pipe Required feet; Minimum Surface Pipe Required 400 feet per Alt.

This Authorization Expires 8-17-86 Approved By 2-17-86

C W/2 SW NE Sec. 29 Twp. 26 S, Rg. 13 East
 West
3300 Ft. from South Line of Section
2310 Ft. from East Line of Section

(Note: Locate well on Section Plat on reverse side)

Nearest lease or unit boundary line 330 feet
County Pratt

Lease Name Jarboe Well # 1

Ground surface elevation feet MSL

Domestic well within 330 feet: yes noMunicipal well within one mile: yes no

Depth to bottom of fresh water 150

Depth to bottom of usable water 300

Surface pipe by Alternate: 1 2

Surface pipe planned to be set 400

Conductor pipe required

Projected Total Depth 4550 feet

Formation Arbuckle


*Was: CN 1/2 NE 4220 B/L
1320 F/L

Must be filed with the K.C.C. five (5) days prior to commencing well
This card void if drilling not started within six (6) months of date received by K.C.C.

Important procedures to follow:

1. Notify District office before setting surface casing.
2. Set surface casing by circulating cement to the top.
3. File completion forms ACO-1 with K.C.C. within 90 days of well completion, following instructions on ACO-1, side 1, and including copies of wireline logs.
4. Notify District office 48 hours prior to old well workover or re-entry.
5. Prior to filing Intent, prepare a proposed plugging plan in case well is D & A, then obtain approval of plan when calling district office prior to setting surface pipe.
6. Submit plugging report (CP-4) to K.C.C. after plugging is completed.
7. Obtain an approved injection docket number before disposing of salt water.
8. Notify K.C.C. within 10 days when injection commences or terminates.
9. If an alternate 2 completion, cement in the production pipe from below any usable water to surface within 120 days of spud date.

A Regular Section of Land
1 Mile = 5,280 Ft.

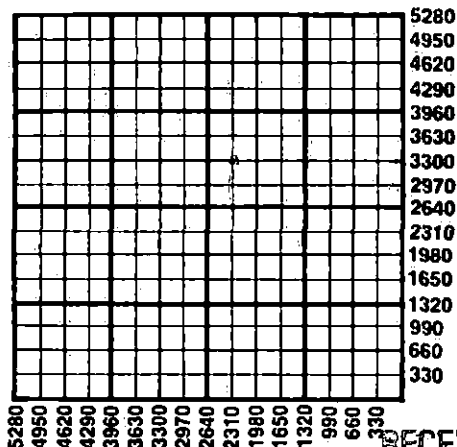

RECEIVED
STATE CORPORATION COMMISSION

FEB 20 1986
2-20-86
CONSERVATION DIVISION
Wichita, Kansas

State Corporation Commission of Kansas
Conservation Division
200 Colorado Derby Building
Wichita, Kansas 67202
(316) 263-3238