

CARD MUST BE TYPED

NOTICE OF INTENTION TO DRILL

CARD MUST BE SIGNED

(see rules on reverse side)

Starting Date: MARCH 5th 1985
month day year 2:30

OPERATOR: License # 5298
Name GOULD OIL, INC.
Address P.O. BOX 8640
City/State/Zip WICHITA, KS 67208
Contact Person DALE P. JEWETT
Phone 316-682-5523

CONTRACTOR: License # 5380
Name EAGLE DRILLING, INC.
City/State WICHITA, KS

Well Drilled For: Well Class: Type Equipment:
Oil Swd Infield Mud Rotary
Gas Inj Pool Ext Air Rotary
OWWO Expl Wildcat Cable

If OWWO: old well info as follows:
Operator
Well Name
Comp. Date Old Total Depth
Projected Total Depth 4850 feet
Projected Formation at TD ARBUCKLE
Expected Producing Formations MISSISSIPPIAN, VIOLA, SIMPSON

I certify that we will comply with K.S.A. 55-101, et seq., plus eventually plugging hole to K.C.C. specifications.

Date 3-1-85 Signature of Operator or Agent

Signature of Dale P. Jewett

VICE-PRESIDENT

MHC/MOHE 3-4-85

API Number 15- 151-21,584-00-00
50' S & 100' W OF
C W/2 NE NW Sec 22 Twp 29 S, Rge 15
4570 Ft North from Southeast Corner of Section
3730 Ft West from Southeast Corner of Section
(Note: Locate well on Section Plat on reverse side)

Nearest lease or unit boundary line 710 feet.
County PRATT
Lease Name HOGARD Well# 1
Domestic well within 330 feet: yes no
Municipal well within one mile: yes no

Depth to Bottom of fresh water 75 feet
Lowest usable water formation UNKNOWN Top Pelvic
Depth to Bottom of usable water UNKNOWN 200 feet
Surface pipe by Alternate: 1 2581
Surface pipe to be set 200 feet
Conductor pipe if any required 40 feet
Ground surface elevation APPROX. 1960 feet MSL
This Authorization Expires 3-4-85 7-4-85


Approved By Signature Title

RECEIVED
STATE CORPORATION COMMISSION

Must be filed with the K.C.C. five (5) days prior to commencing well
This card void if drilling not started within six (6) months of date received by K.C.C.

MAR 4 1985
3-4-85

CONSERVATION DIVISION
A Regular Section of Land
1 Mile = 5,280 Ft.

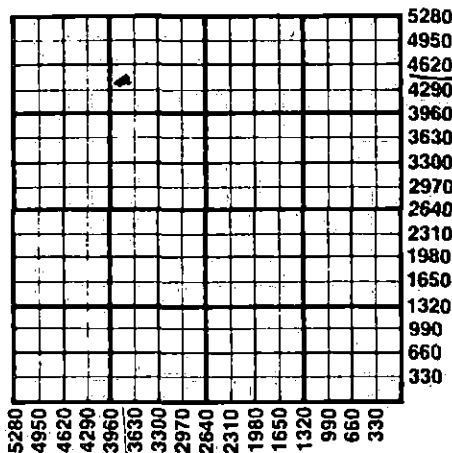

Important procedures to follow :

1. Notify District office before setting surface casing.
2. Set surface casing by circulating cement to the top.
3. File completion forms ACO-1 with K.C.C. within 90 days of well completion, following instructions on ACO-1, side 1, and including copies of wireline logs.
4. Notify District office 48 hours prior to old well workover or re-entry.
5. Prior to plugging, prepare a plugging plan, then obtain agreement from the appropriate district office for an approved plugging plan.
6. Submit plugging report (CP-4) to K.C.C. after plugging is completed.
7. Obtain an approved injection docket number before disposing of salt water.
8. Notify K.C.C. within 10 days when injection commences or terminates.
9. If an alternate 2 completion, cement in the production pipe from below any usable water to surface within 120 days of spud date.

State Corporation Commission of Kansas
Conservation Division
200 Colorado Derby Building
Wichita, Kansas 67202
(316) 263-3238