

CORRECTED COPY

CARD MUST BE TYPED

State of Kansas
NOTICE OF INTENTION TO DRILL

(see rules on reverse side)

CORRECTION
CARD MUST BE SIGNED

3-21-85

Starting Date: June 15 1984
month day year

API Number 15- 155-20,995 - 0000

OPERATOR: License # 8594
Name T. D. R. Exploration Company
Address Route 7, Box 59
City/State/Zip Houma, LA 70364
Contact Person James C. Harper
Phone (504) 868-7623

X NE NE NE Sec 25 Twp 22 S Rge 10
(location) East West

CONTRACTOR: License # 5418
Name Allen Drilling Co
City/State Box 1389/Great Bend, KS 67530

* 4950 Ft North from Southeast Corner of Section
* 330 Ft West from Southeast Corner of Section
(Note: Locate well on Section Plat on reverse side)

Well Drilled For: Well Class: Type Equipment:
 Oil Swd Infield Mud Rotary
 Gas Inj Pool Ext. Air Rotary
 OWWO Expl Wildcat Cable

Nearest lease or unit boundary line 330 feet
County Reno
Lease Name Sleeper Well# 1-25
Domestic well within 330 feet: yes no
Municipal well within one mile: yes no

If OWWO: old well info as follows:

Depth to Bottom of fresh water 230+ feet
Lowest usable water formation Ninescaw Shale
Depth to Bottom of usable water 230+ feet
Surface pipe by Alternate: 1 2
Surface pipe to be set 300 feet
Conductor pipe if any required feet
Ground surface elevation 1750 feet MSL
This Authorization Expires 11-29-84
Approved By 5-29-84

Operator
Well Name
Comp Date Old Total Depth
Projected Total Depth 3865 feet
Projected Formation at TD Arbuckle
Expected Producing Formations Simpson/Viola

I certify that we will comply with K.S.A. 55-101, et seq., plus eventually plugging hole to K.C.C. specifications.

Original Date 5/29/84
Signature of Operator or Agent

J. C. Harper
Title President
4950 FEL


Must be filed with the K.C.C. five (5) days prior to commencing well
 This card void if drilling not started within six (6) months of date received by K.C.C.
 REC'D
 STATE CORPORATION COMMISSION

3-19-85

MAR 19 1985

Important procedures to follow:

A Regular Section of Land
 1 Mile = 5,280 Ft.

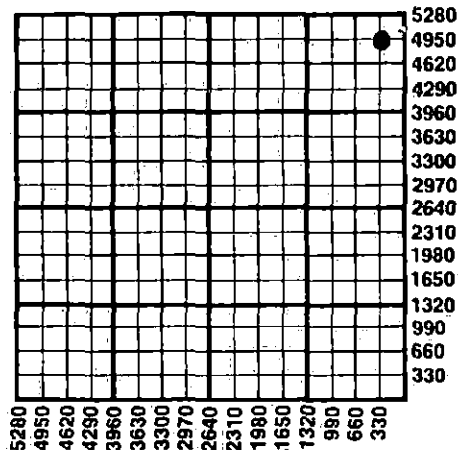

CONSERVATION
 Division
 Wichita, Kan

1. Notify District office before setting surface casing.
2. Set surface casing by circulating cement to the top.
3. File completion forms ACO-1 with K.C.C. within 90 days of well completion, following instructions on ACO-1, side 1, and including copies of wireline logs.
4. Notify District office 48 hours prior to old well workover or re-entry.
5. Prior to plugging, prepare a plugging plan, then obtain agreement from the appropriate district office for an approved plugging plan.
6. Submit plugging report (CP-4) to K.C.C. after plugging is completed.
7. Obtain an approved injection docket number before disposing of salt water.
8. Notify K.C.C. within 10 days when injection commences or terminates.
9. If an alternate 2 completion, cement in the production pipe from below any usable water to surface within 120 days of spud date.

State Corporation Commission of Kansas
 Conservation Division
 200 Colorado Derby Building
 Wichita, Kansas 67202
 (316) 263-3238